


ST ANTHONY PARK

RAMSEY Co

MINNESOTA.

SHEET No 1

SCALE 1"=200 FT.

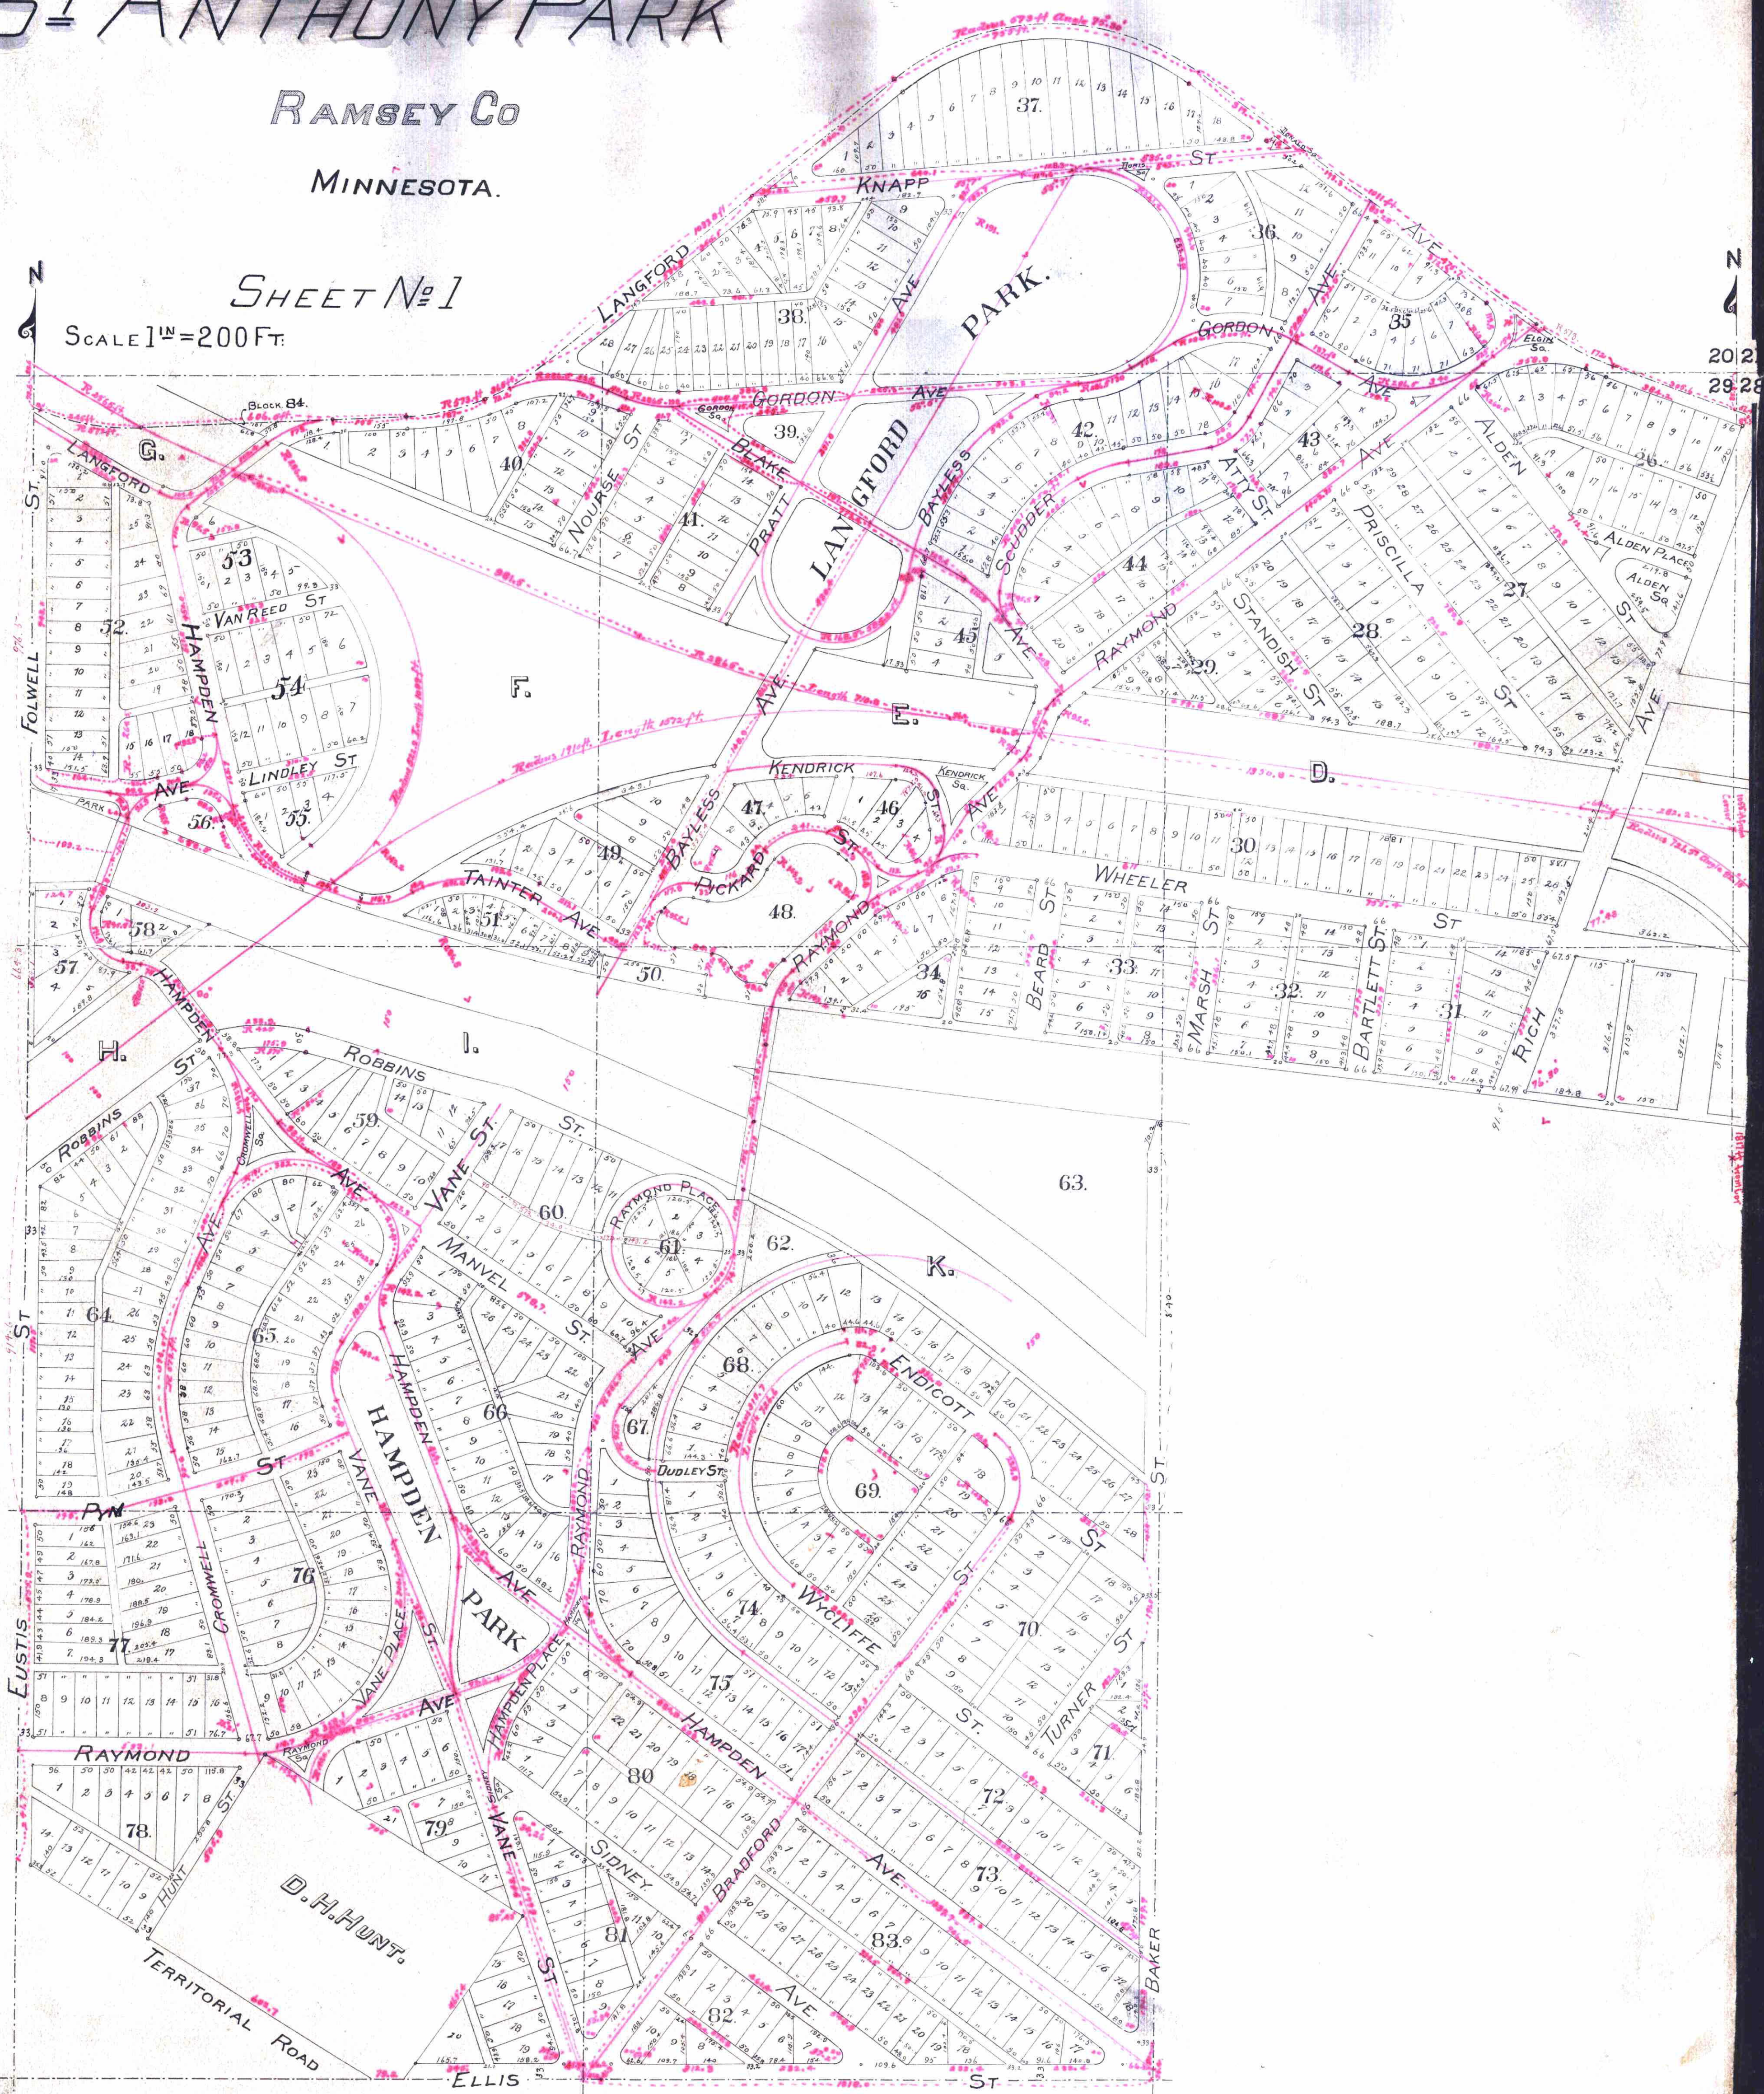

202
2928