I hereby certify to having surveyed and platted the property as described on this map as KELLY'S RE'ARRANGEMENT, and have placed iron monuments at the corners of each and every block as shown on this map, and the same is correct.

Charles A. Forbes
Surveyor.

STATE OF MINNESOTA, County of Ramsey, } ss.

On this thirtieth day of April A. D. 1887, personally appeared before the undersigned, CHARLES A. FORBES, to me well known, and acknowledged that he executed the foregoing Certificate as his own free act and deed.

O. H. Hubbard
Notary Public, Ramsey Co., Minn.

This is to certify that I Richard Leffmann proprietor of OXFORD ADDITION BLOCK 1 have caused the same to be surveyed and platted, and hereafter known as KELLY'S RE-ARRANGEMENT OF BLOCK 1, OXFORD ADDITION as shown by this plat, and hereby dedicate to the public, and for the public use forever, all the Streets, Avenues, Alleys, Parks and Boulevards, as herein indicated.

Witness my hand and seals, this Second day of May 1887.

In presence of

Edward Kelly
P. E. Murphy

Richard Leffmann

State of Minnesota, County of Ramsey } On this 2d day of May A. D. 1887, personally came before me, the undersigned, Richard Leffmann to me well known, and he acknowledged that he executed the foregoing Certificate for the uses and purposes therein expressed.

Joseph Bergfeld
Notary Public,
Ramsey County, Minn.

Accepted and approved this Third day of May A. D. 1887

S. P. Scolson
Jno. Starkey
L. W. Randolph
Plat Commissioners.

Accepted by the Common Council of the City of St. Paul, on the Third day of May 1887.

Thos. Mondugent
City Clerk
Dep. Deputy

CITY TREASURER'S OFFICE
ST. PAUL, MINN.
MAY 6 1887
TREASURER'S OFFICE
ST. PAUL, MINN.

M. Doyle
Treas.

Dated St. Paul May 7. 1887

M. D. Kain
County Auditor
By Olsen
Deputy

KELLY'S

Re-arrangement of Block 1

OXFORD ADDITION

City of St. Paul. Minn.

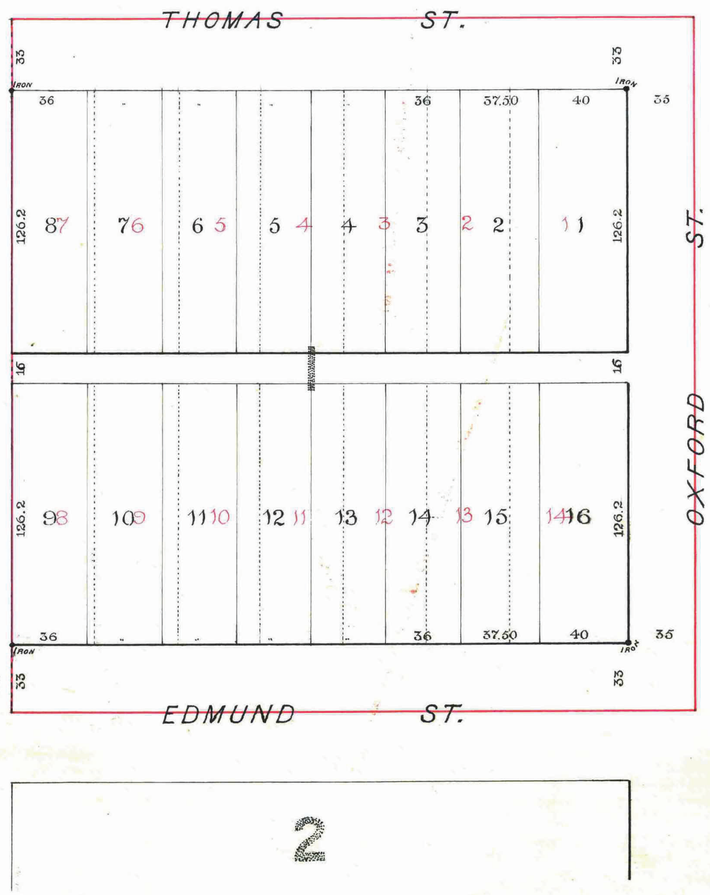

No 7064.

STATE OF MINNESOTA, County of Ramsey. } ss.

Office of the Register of Deeds.

This is to certify that the within instrument was filed for Record in this Office, at St. Paul, on the 7 day of May A. D. 18 87 at 2 o'clock P. M., and that the same was duly recorded in Book 6 of Town Plats pages 46

M. Doyle
Register of Deeds.

By Deputy.

This plat document is an UNOFFICIAL copy of a Subdivision Plat or Registered Land Survey and is made available for information purposes only.

To obtain an official copy please contact the Ramsey County Recorder's Office.

RAMSEY COUNTY