

# LANBERG'S RE-ARRANGEMENT OF BLOCK 13 BEAUPRE AND KELLY'S ADDITION

to the City of St. Paul, Minn.

This plat document is an UNOFFICIAL copy of a Subdivision Plat or Registered Land Survey and is made available for information purposes only.  
To obtain an official copy please contact the Ramsey County Recorder's Office.

I hereby certify to having surveyed and platted the property as described on this map as Langberg's Re-arrangement of Block 13 <sup>Beaupre & Kelly's addition</sup> and have placed iron monuments at the corners of each and every block as shown on this map, and the same is correct.  
Charles A. Forbes  
Surveyor.

STATE OF MINNESOTA, } ss.  
County of Ramsey, }  
On this 17<sup>th</sup> day  
of May A. D. 1887, personally appeared before the undersigned, CHARLES A. FORBES, to me well known, and acknowledged that he executed the foregoing Certificate as his own free act and deed.  
Edward J. Godfrey  
Notary Public, Ramsey Co., Minn.

OFFICE OF COUNTY TREASURER, ST. PAUL, MINN.  
MAY 17 1887  
1886 TAX PAID.  
F. A. RENZ, Co. Treas.

This is to certify that John M. Carlson, Christian Carlson, his wife, P. A. Lanberg, Christine Lanberg, his wife, Gustav Carlson, Clara C. Carlson, his wife, and P. A. Lanberg proprietors of Block Thirteen (13) Beaupre & Kelly's Addition to the City of Saint Paul have caused the same to be surveyed and platted, and hereafter known as Langberg's Re-arrangement of Block 13 Beaupre & Kelly's Addition to St. Paul as shown by this plat, and hereby dedicate to the public, and for the public use forever, all the Streets, Avenues, Alleys, Parks and Dead-ends, as herein indicated.

Witness our hands and seals, this 17<sup>th</sup> day of May 1887.  
In presence of  
Edward J. Godfrey } John M. Carlson }  
Charles A. Forbes } Christin Carlson }  
H. A. Stone } P. A. Lanberg }  
J. J. Sawyer } Christin Lanberg }  
} Gustav Carlson }  
} Clara C. Carlson }  
State of Minnesota, }  
County of Ramsey, }  
On this Seventeenth day of May A. D. 1887, personally came before me, the undersigned, John M. Carlson, Christian Carlson, his wife, P. A. Lanberg and Christin Lanberg his wife to me well known, and they acknowledged that they executed the foregoing Certificate for the uses and purposes therein expressed.  
Edward J. Godfrey  
Notary Public,  
Ramsey County, Minn.


On this 17<sup>th</sup> day of May A. D. 1887, personally appeared before me, the undersigned, John M. Carlson, Christian Carlson, his wife, P. A. Lanberg and Christin Lanberg his wife to me well known, and they acknowledged that they executed the foregoing Certificate for the uses and purposes therein expressed.  
Edward J. Godfrey  
Notary Public,  
Ramsey County, Minn.

CITY TREASURER'S OFFICE  
ST. PAUL, MINN.  
MAY 10 1887  
ASSESSMENTS PAID  
W. J. Wood  
CITY TREAS.

Accepted and approved this 17<sup>th</sup> day of May A. D. 1887  
W. J. Wood  
W. J. Wood  
Plat Commissioners.

Accepted by the Common Council of the City of St. Paul, on the day of May 1887  
W. J. Wood  
City Clerk.

Pauls paid May 21 1887  
W. J. Wood  
County Auditor  
per W. J. Wood

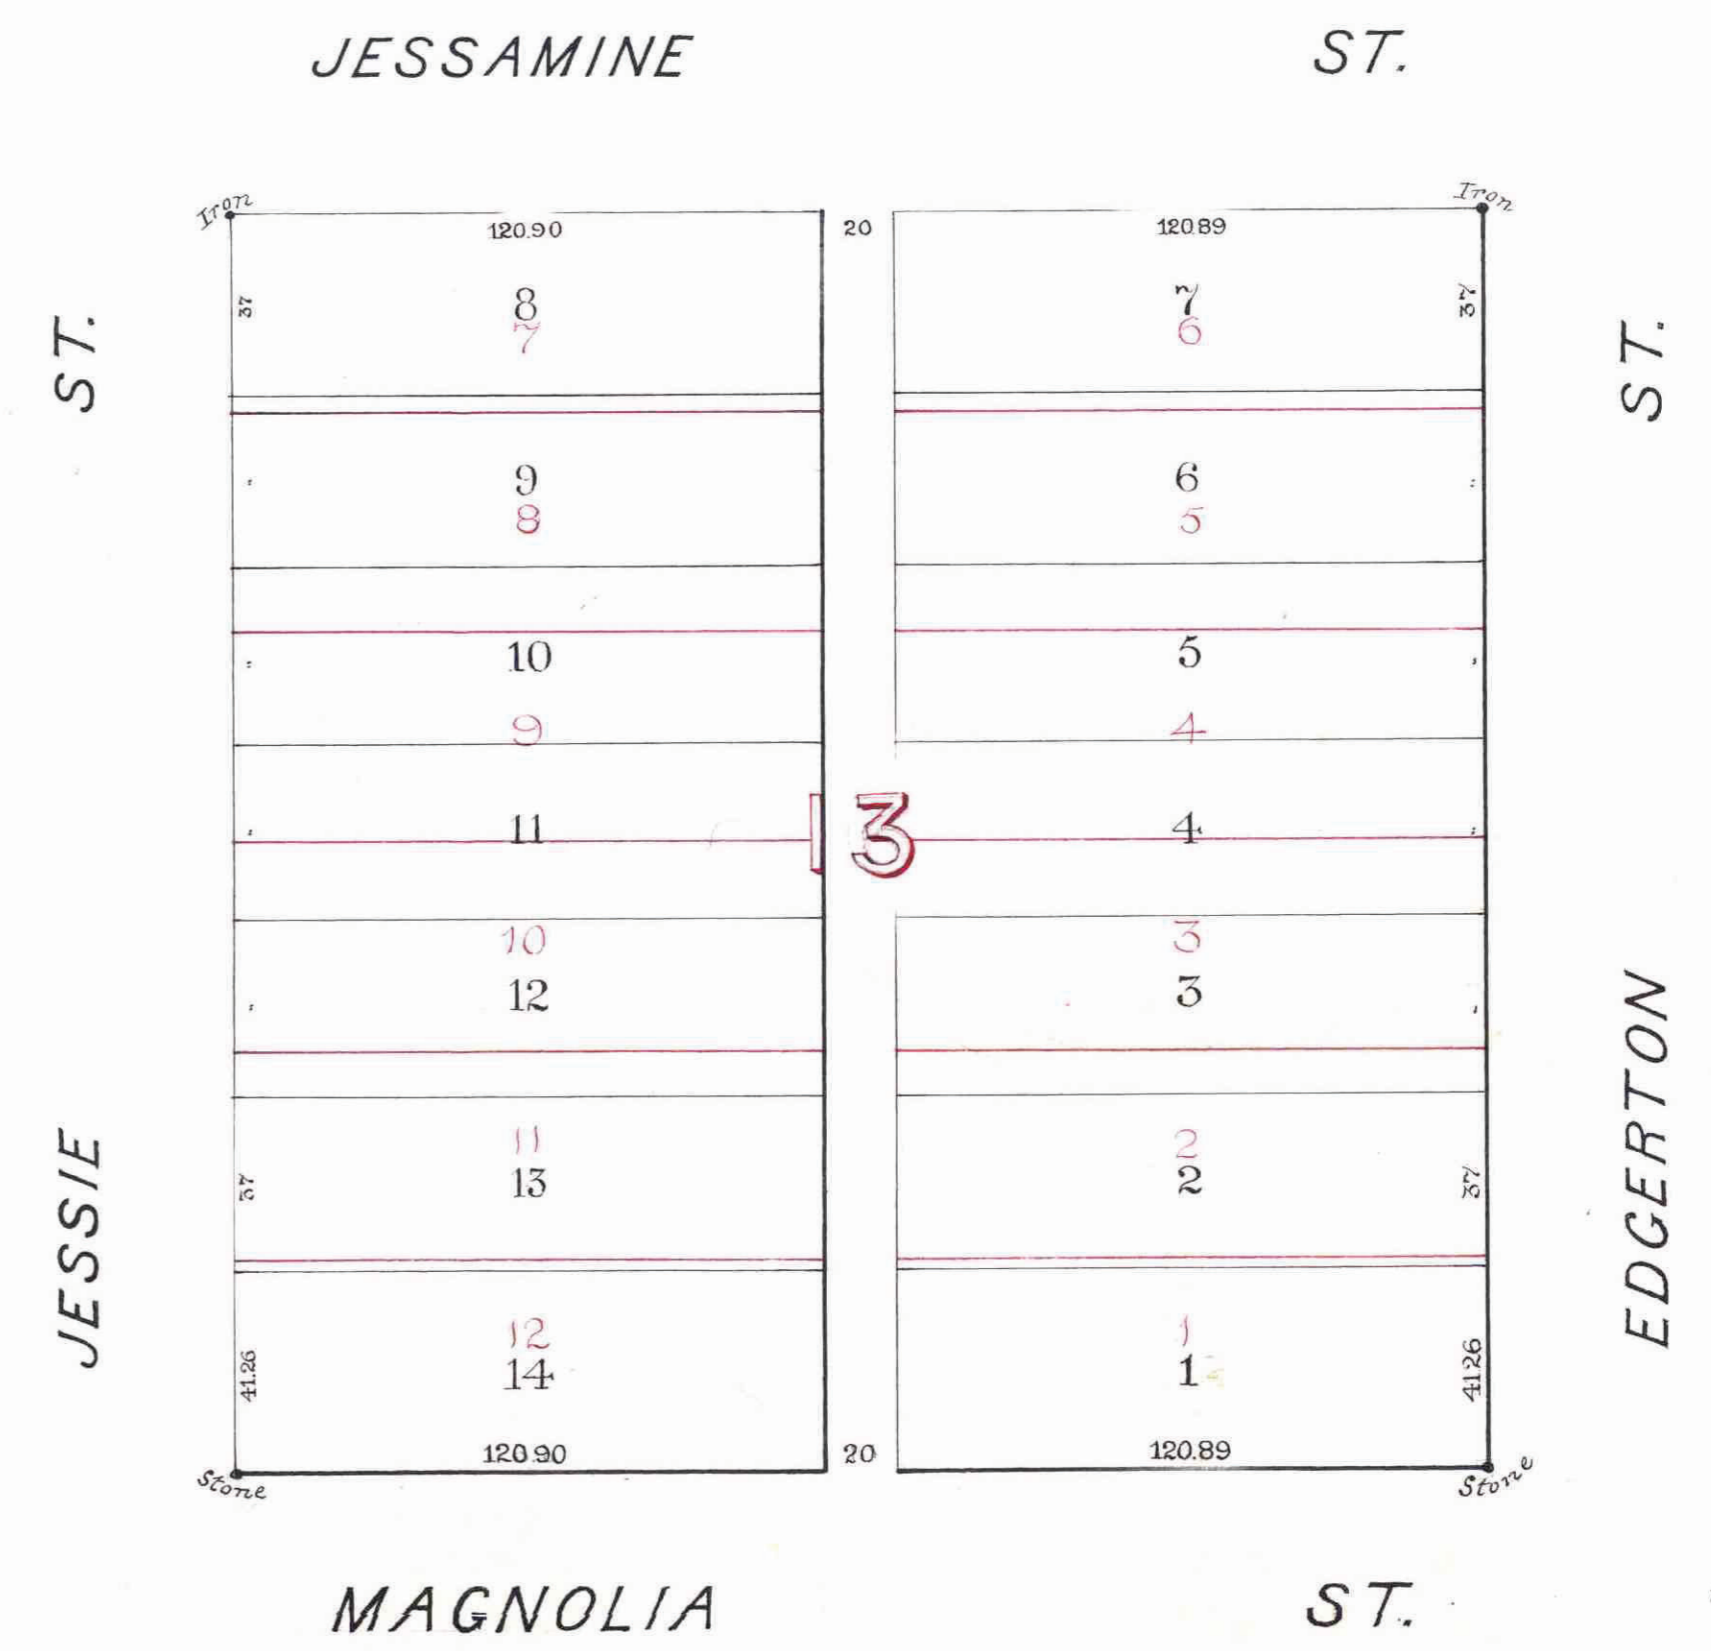

STATE OF MINNESOTA, } ss.  
County of Ramsey, }  
Office of the Register of Deeds  
This is to certify that the within instrument was filed for Record in this Office, at St. Paul, on the 20 day of May A. D. 1887, at 3:00 o'clock P. M., and that the same was duly recorded in Book 10 of Young's Case pages 11 to 12.  
W. J. Wood  
Register of Deeds.