


VAN SLYKE & LEWIS'

RE-ARRANGEMENT OF HUMBIRD'S ADD'N ST. PAUL.

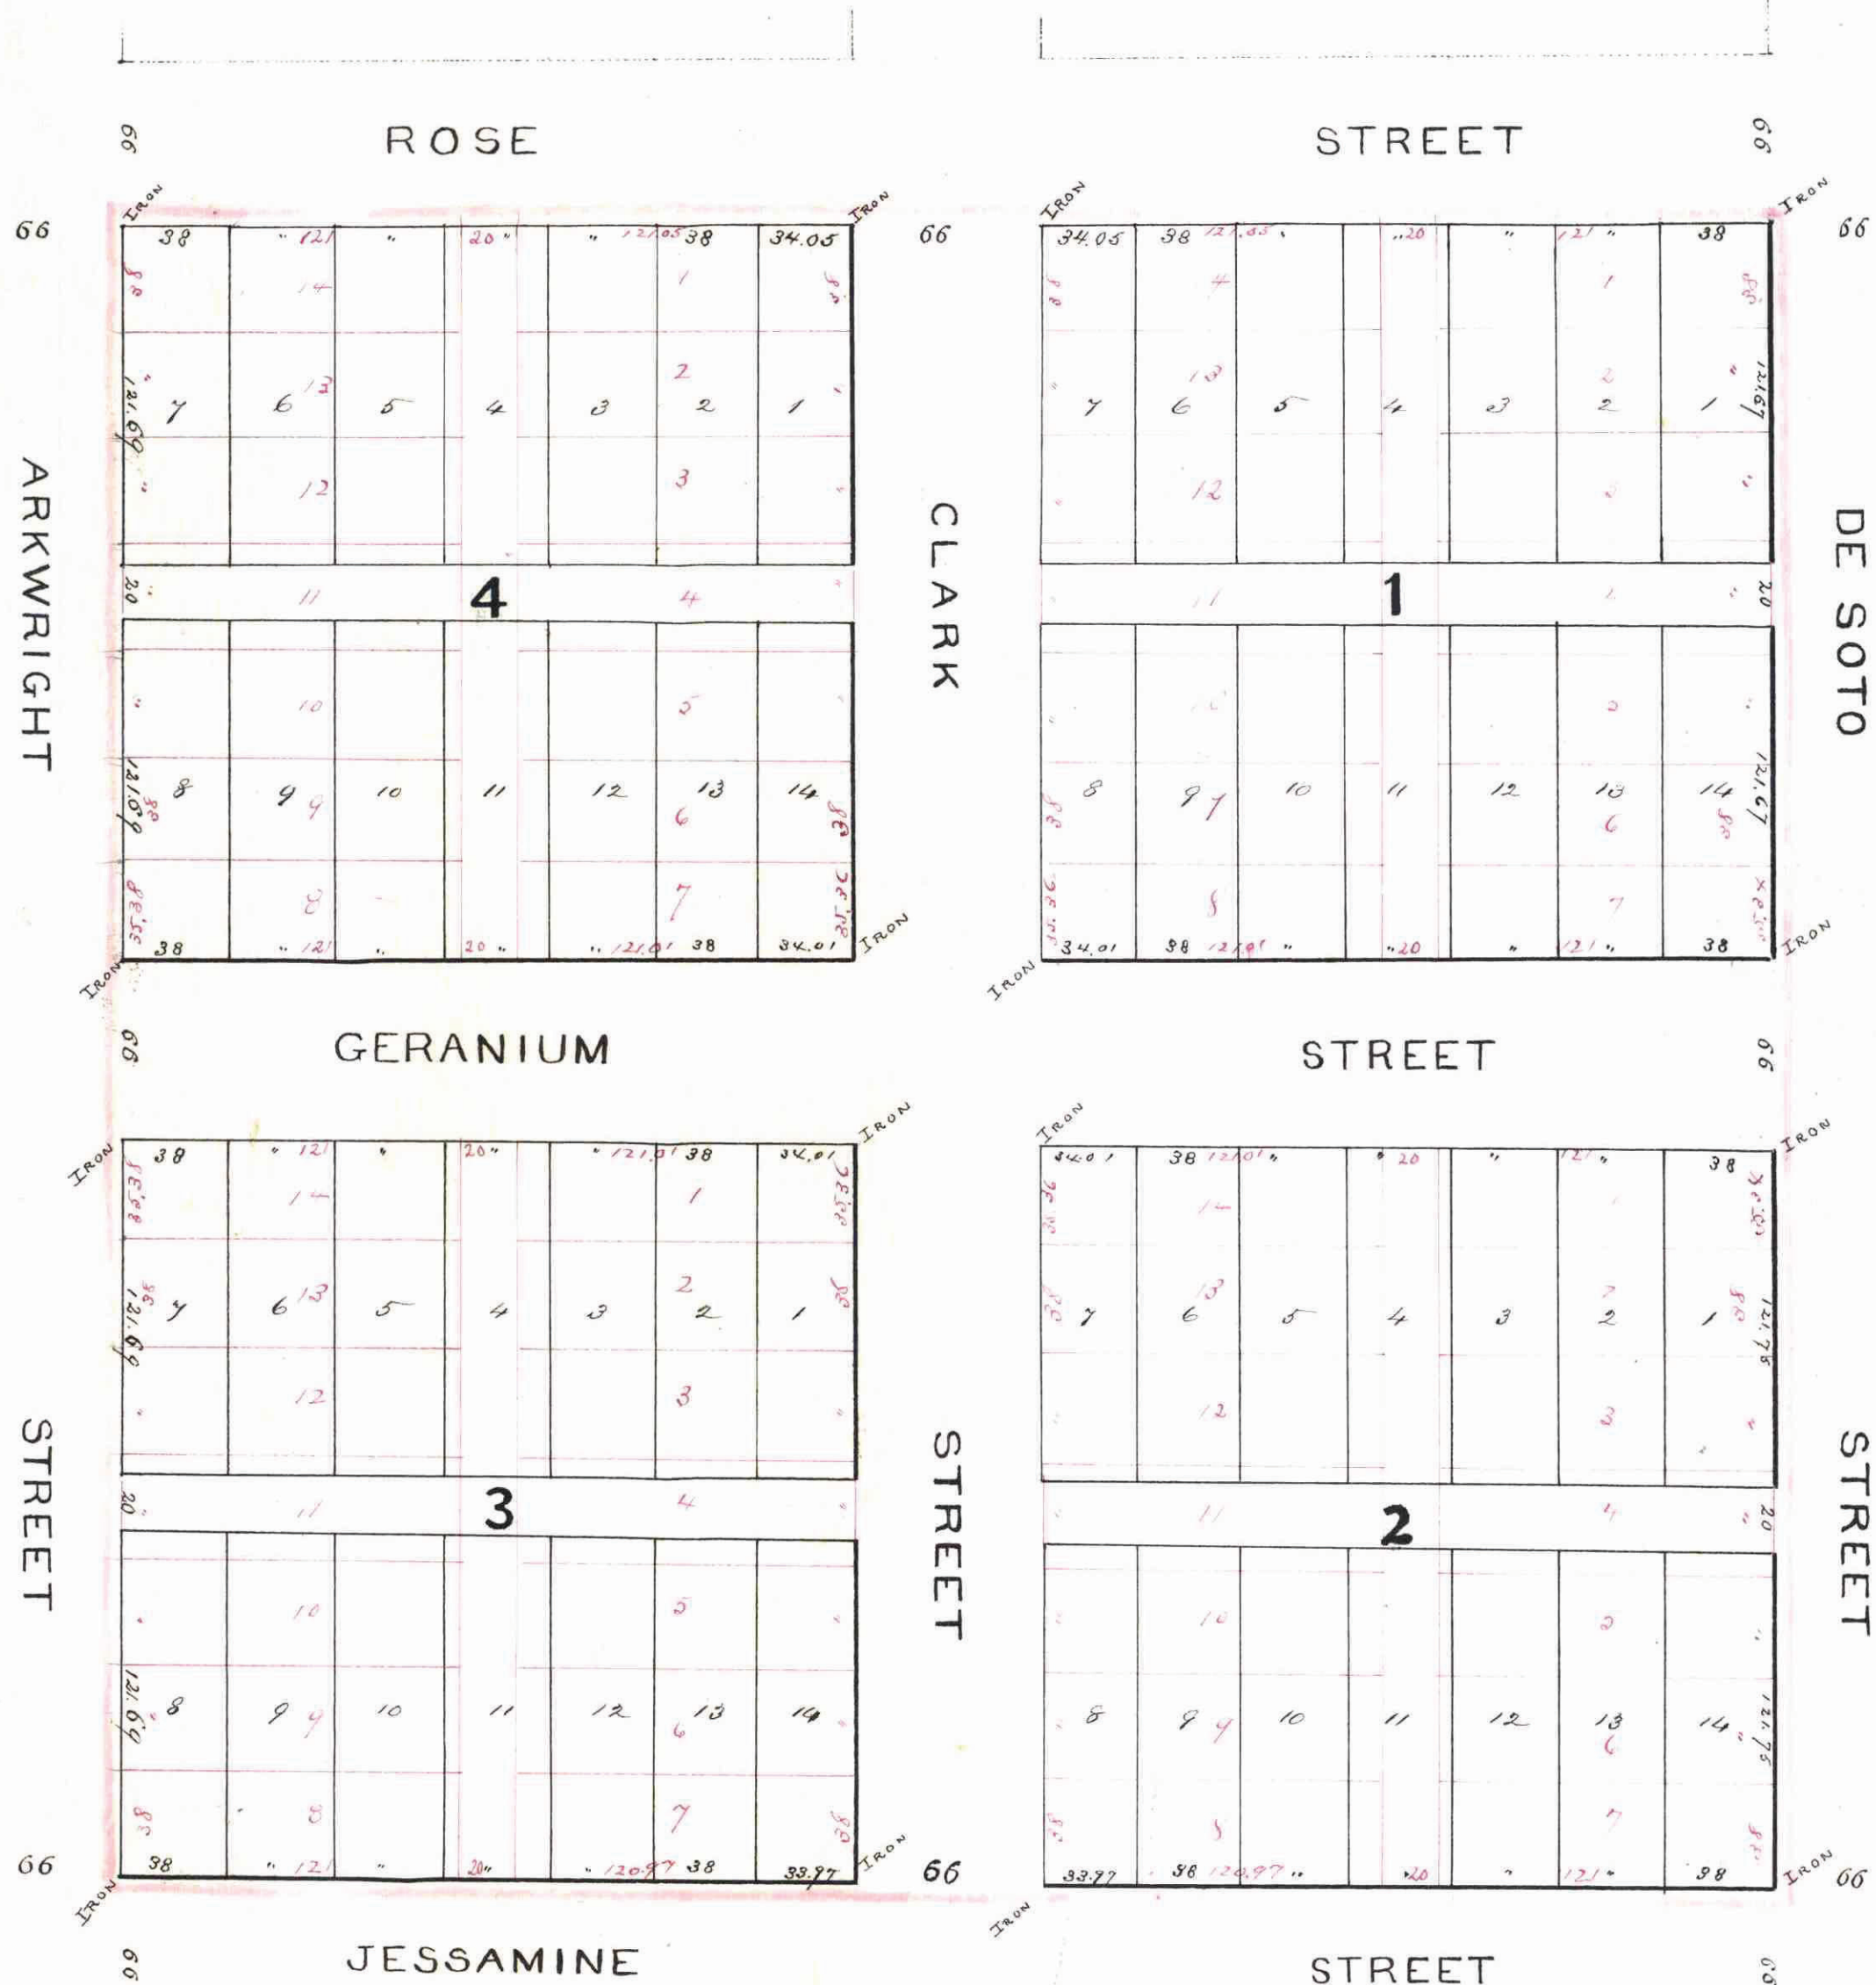

This plat document is an UNOFFICIAL copy of a Subdivision Plat or Registered Land Survey and is made available for information purposes only.

To obtain an official copy please contact the Ramsey County Recorder's Office.

STATE OF MINNESOTA,
County of Ramsey.

Office of the Registrar of Deeds.

This is to certify that the within instrument was filed for Record in this Office, at St. Paul, on the 22nd day of August, A. D. 1887 at 9th o'clock A. M., and that the same was duly recorded in Book 9... of... page 29.

By: *[Signature]*
Registrar of Deeds.

CITY TREASURER,
ST. PAUL, MINN.
AUG 13 1887
1886 TAX PAID.
JENZ. Co. Treas.
[Signature]

CITY TREASURER'S OFFICE
ST. PAUL, MINN.
AUG 13 1887
TAXMENTS PAID
[Signature]

We hereby certify to having surveyed and platted the property as described on this map as "Van Slyke and Lewis' re-arrangement of Humbird's Addition" and have placed iron monuments at the corners of each and every block as shown on this map and the same is correct.

[Signature]
Surveyors.

This is to certify that William A. Van Slyke, Mary S. Van Slyke his wife, Curtis G. Lewis and Loretta G. Lewis his wife, proprietors of Humbird's Addition to St. Paul, being the South half (1/2) of North East quarter (1/4) of North West quarter (1/4) of North West quarter (1/4) of Section Twenty-nine (29) Town Seventy-nine (79) Range Seventy-two (72) West, have caused the same to be surveyed and platted and hereafter known as "Van Slyke & Lewis' re-arrangement of Humbird's Addition to St. Paul," as shown by this plat and hereby dedicate to the public and for the public use for ever, all the streets, avenues, alleys, as herein indicated: Witness our hands and seals this 30th day of July, 1887.

State of Minnesota }
County of Ramsey }

On this 12th day of August A. D. 1887 personally appeared before the undersigned Thos. F. Nichol, of the firm of F. F. Nichol and Son, to me well known and acknowledged that they executed the foregoing certificate as their own free act and deed.

[Signature]
Notary Public
Ramsey Co. Minnesota

accepted by the common council of the city of St. Paul.
on the 13th day of August 1887

[Signature]
City Clerk.

Taxes Paid August 20, 1887.

[Signature]
County Auditor
Ramsey Co. Minnesota

[Signature]
City Treasurer
St. Paul.

In presence of
[Signature]
Wm. A. Van Slyke
Mary S. Van Slyke
Curtis G. Lewis
Loretta G. Lewis

[Signature]
Notary Public
Ramsey Co. Minnesota

accepted and approved this 13th day of August A. D. 1887

[Signature]
Plat Commissioners