

MERRIAM PARK

FIFTH ADDITION TO THE
City of St Paul Minn
1887

I hereby certify to having surveyed and platted the property as described on this map as Merriam Park Fifth Addition and have placed iron monuments at the corners of each and every block as shown on this map, and the same is correct.
Charles A. Forster
Surveyor.

STATE OF MINNESOTA, } ss.
County of Ramsey, }
On this Twenty Ninth day
of September 1887, personally appeared before the undersigned, CHARLES A. FORSTER, Surveyor, and acknowledged that he executed the foregoing Certificate as his own free act and deed.
Eduard J. Godfrey
Notary Public, Ramsey Co., Minn.


This is to certify that Mary Barton, William S. Barton, James M. Partlen and James A. Meade, of the City of Saint Paul, Minnesota proprietors of Lots 164, 165, 166, 167, 177, 178, 179, 180, 181, 182, 183, 184, 185, Hewitts Out Lots First Division have caused the same to be surveyed and platted, and hereafter known as Merriam Park Fifth Addition to the City of Saint Paul, Minnesota as shown by this plat, and hereby dedicate to the public, and for the public use forever, all the Streets, Avenues, Alleys, Parks and Boulevards, as herein indicated.

Witness our hands and seals, this Twenty Ninth day of September 1887.
In presence of
Eduard J. Godfrey
Charles A. Forster
Mary Barton
William S. Barton
James M. Partlen
James A. Meade

State of Minnesota, }
County of Ramsey, }
On this Twenty Ninth day of September A. D. 1887, personally came before me, the undersigned, Mary Barton, William S. Barton, husband, James M. Partlen, bachelor, James A. Meade, bachelor to me well known, and they acknowledged that they executed the foregoing Certificate for the uses and purposes therein expressed.
Eduard J. Godfrey
Notary Public,
Ramsey County, Minn.

Accepted and approved this First day of October A. D. 1887
J. J. Johnson
Ed. Starkey
Plat Commissioners.

Accepted by the Common Council of the City of St. Paul, on the 18th day of October 1887
Charles Anderson
City Clerk

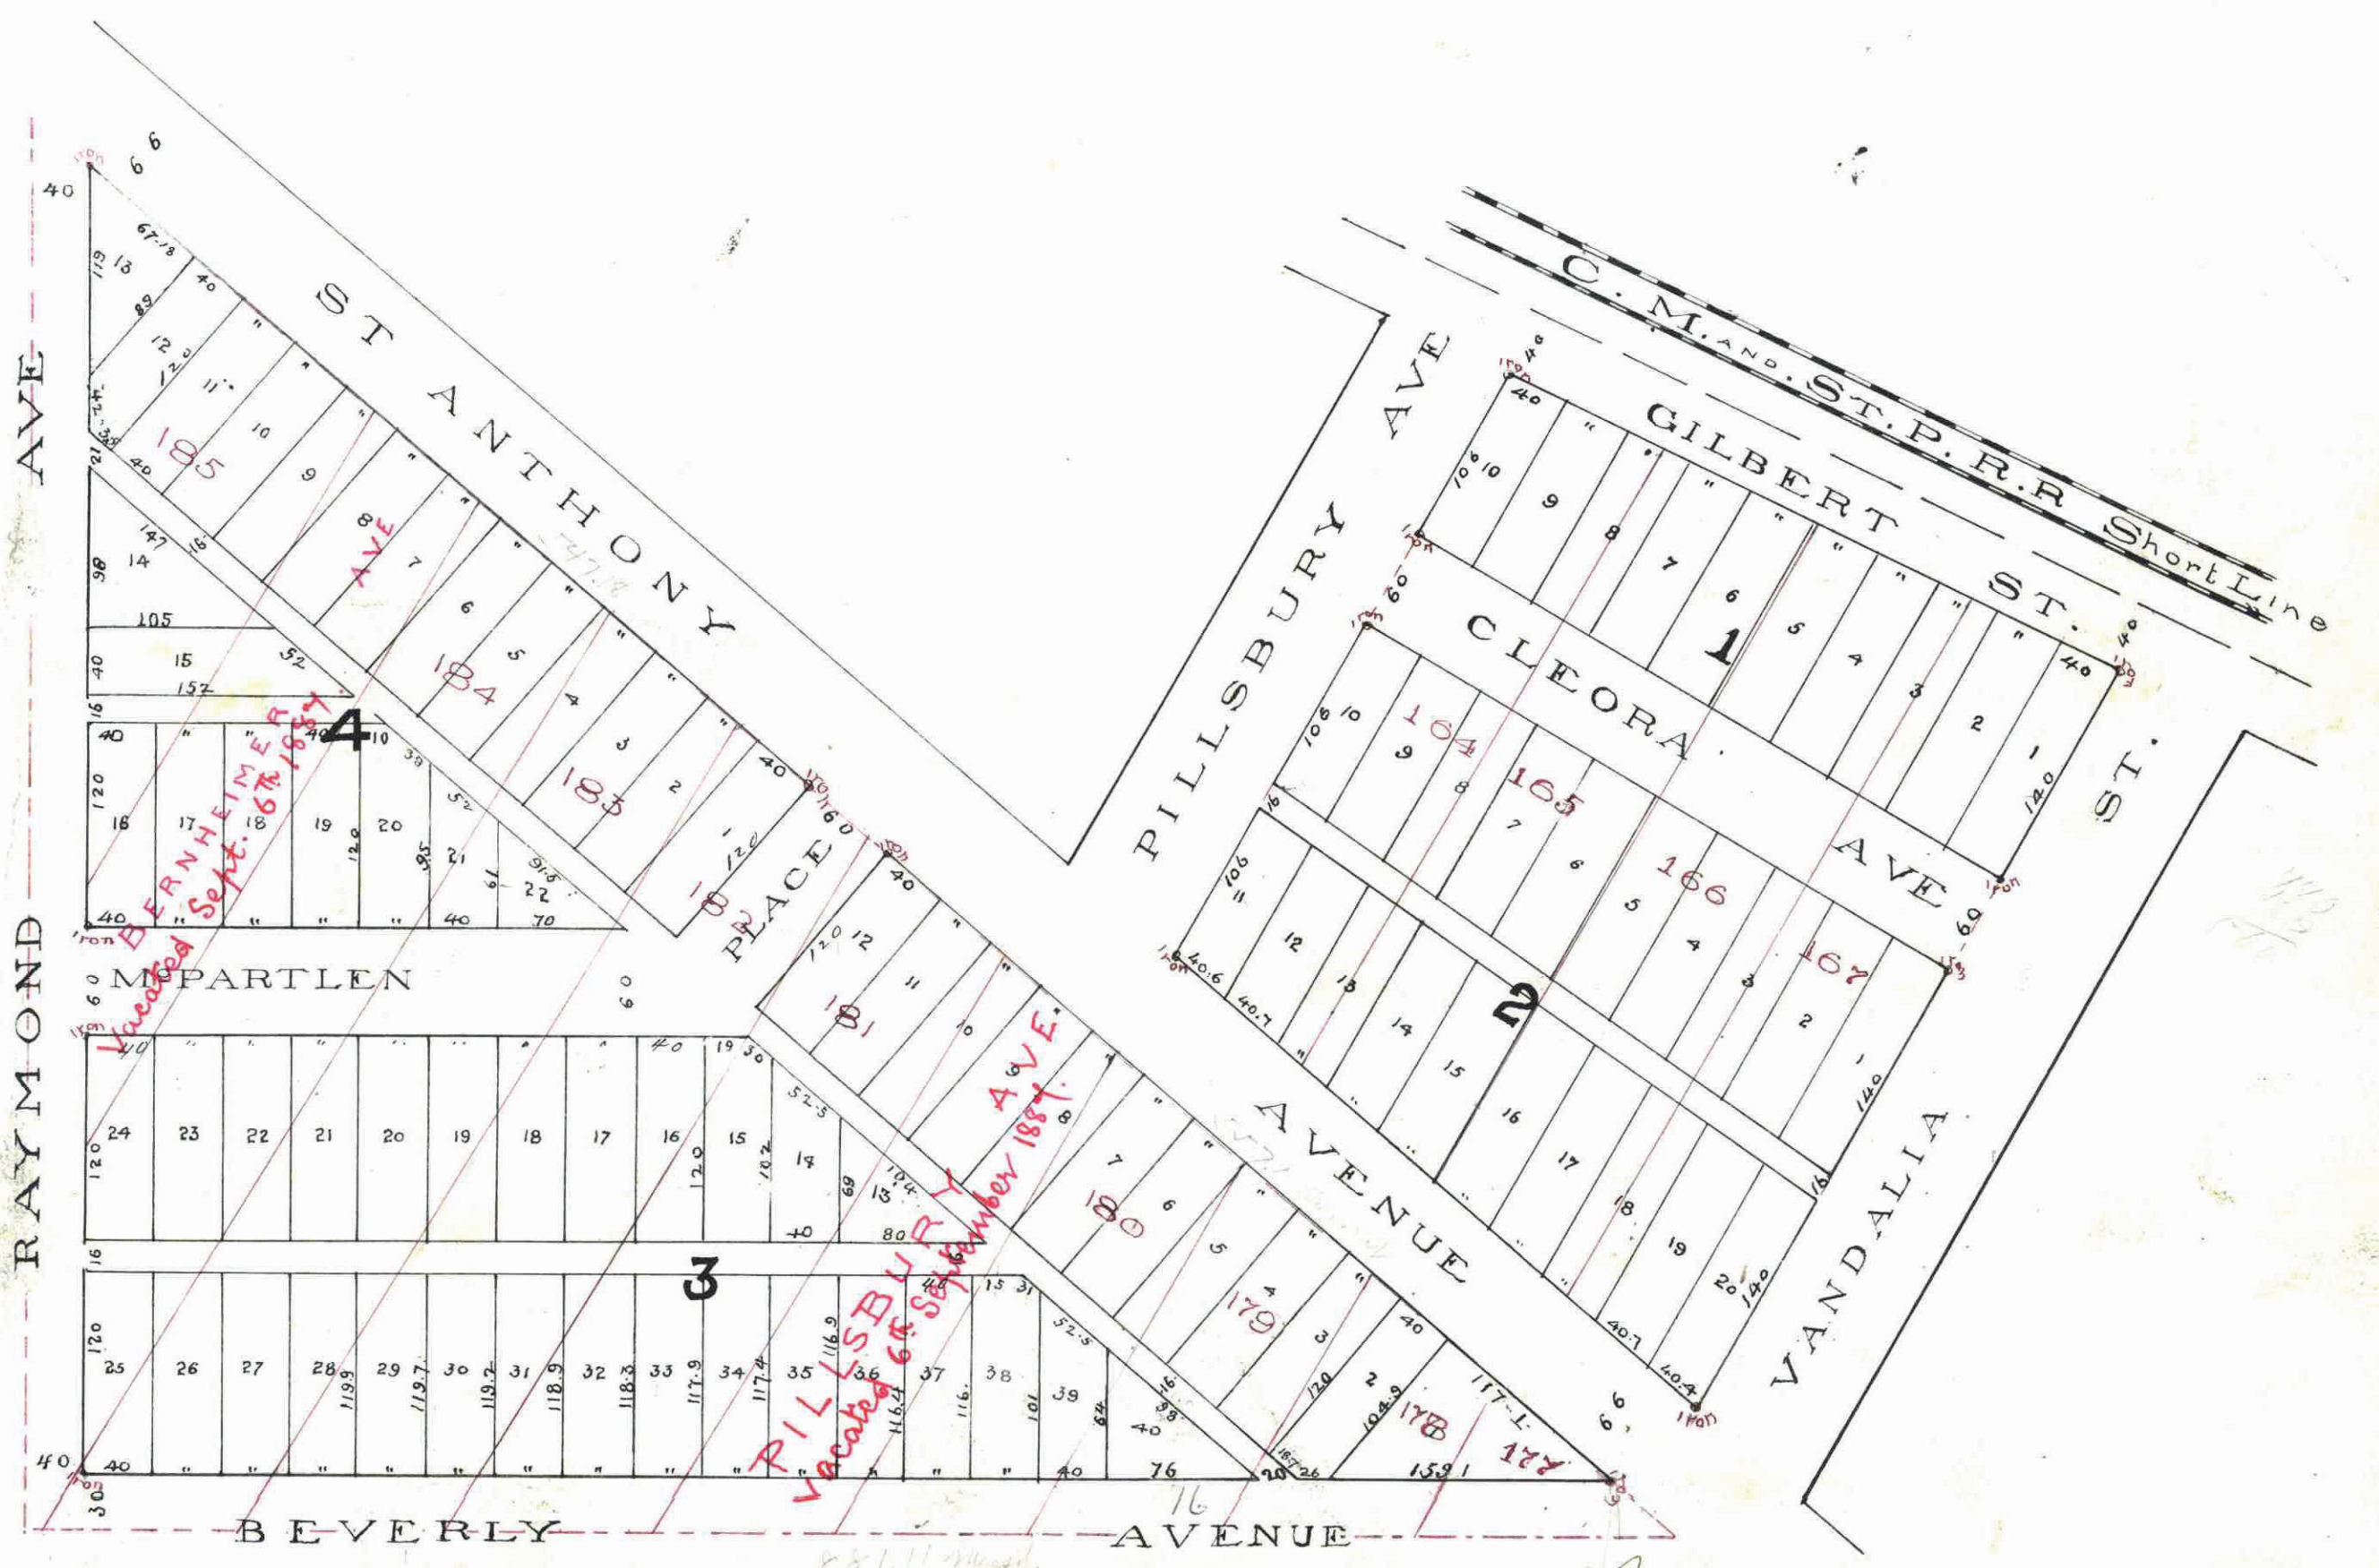

STATE OF MINNESOTA, } ss.
County of Ramsey, }
Notary Public,
Ramsey County, Minn.

This plat document is an UNOFFICIAL copy of a Subdivision Plat or Registered Land Survey and is made available for information purposes only.
To obtain an official copy please contact the Ramsey County Recorder's Office.

TREASURER'S OFFICE
ST. PAUL, MINN.
OCT 1 1887
George
Treasurer

Taxes Paid and Transfer Entered
NOV 19 1887
M. F. KAIN, Notary Auditor.
M. F. Kain