

SHERWOOD'S
RE ARRANGEMENT
OF THE
SOUTH HALF OF BLOCK FIVE
JACKSON & BIDWELLS ADDITION
to
ST PAUL
MINNESOTA.

80

80


60

60

CURTICE ST.

STRYKER AVE.

HALL AVE.

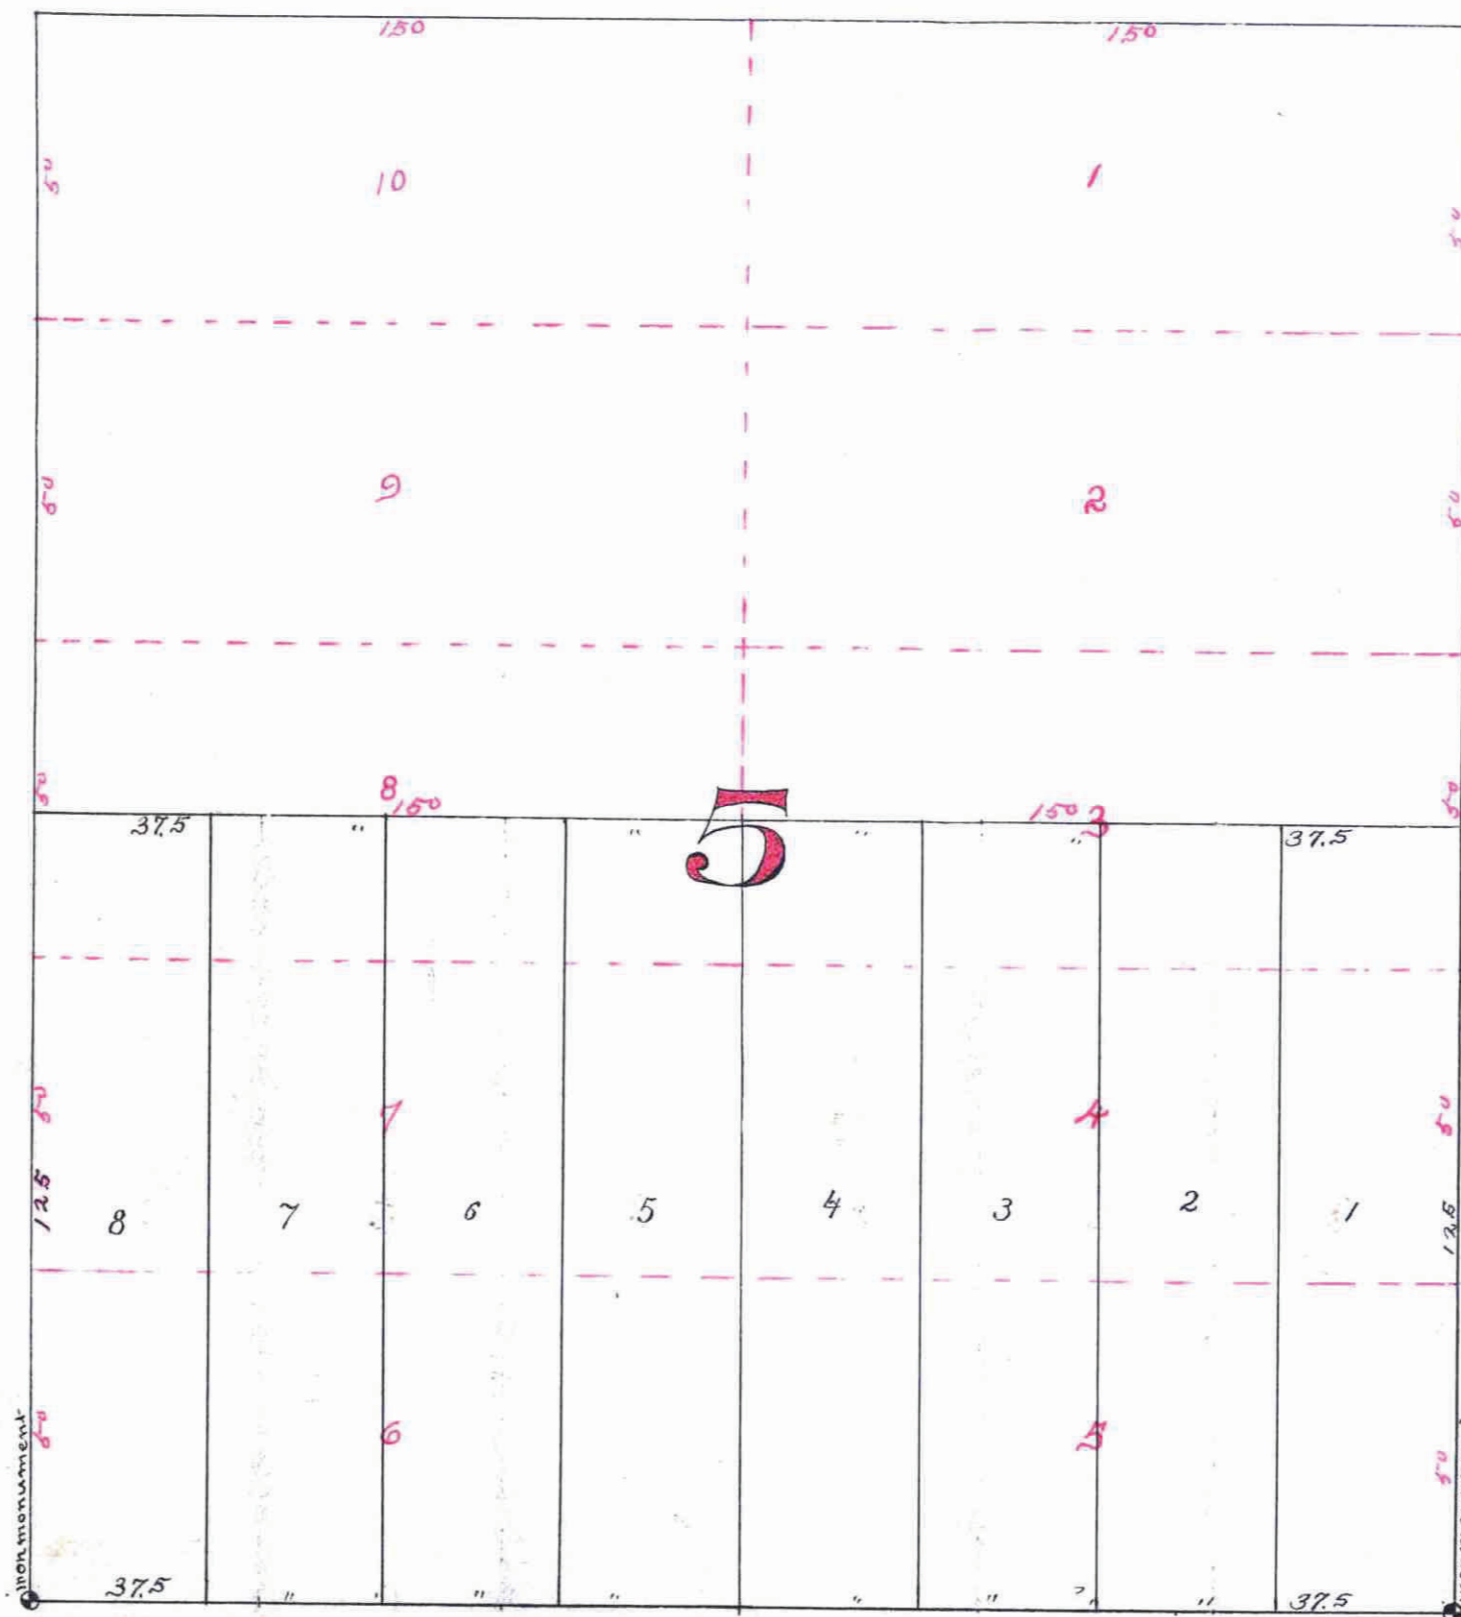

BELVIDERE ST.

80

80

Thereby certify to having surveyed and platted the property as described on this map as Sherwood's Re-arrangement of the South Half of Block 5 of Jackson and Bidwells Addition to St. Paul and have placed iron monuments at the block corners as shown on this map and the same is correct

H. Phillips
 Surveyor

State of Minnesota }
 County of Ramsey }
 On this 6th day of August A.D. 1887 personally appeared before the undersigned H.L. Phillips to me well known, and acknowledged that he executed the foregoing certificate as his own free act and deed.

F. Sherwood

Notary Public

Ramsey Co Minn.

This is to certify that Frank G. Sherwood, proprietor of the South Half of Block 5 of Jackson and Bidwells Addition to St. Paul, has caused the same to be surveyed and platted, and hereafter known as Sherwood's Re-arrangement of the South Half of Block 5 of Jackson and Bidwells Addition to St. Paul, as shown by this plat, and hereby dedicates to the public, and for the public use forever, all the streets and avenues as herein indicated.

Witness my hand and seal, this 8th day of August 1887

Frank G. Sherwood (Seal)

In the presence of

E. C. Buffum

F. N. Blackmer

State of New York }
 County of Monroe }
 Be it known that on this 5th day of August

A.D. 1887 before me personally came *Frank G. Sherwood* unassisted to me known to be the identical person described and who executed the foregoing instrument and who acknowledged that he executed the same freely and voluntarily for the uses and purposes therein expressed.

E. C. Buffum

Notary Public in and for County of Monroe State of New York

Accepted and approved this 30th day of August 1887

J. P. Tolson

J. P. Starkey

Wm. Lauder

Plat Commission.

Accepted by the common council of the city of St. Paul on the 19th day of August 1888

J. J. [Signature]
 City Clerk

STATE OF MINNESOTA, ss.
 County of Ramsey.
 Office of the Register of Deeds.
 This is to certify that the within instrument was filed for Record in this Office, at St. Paul, on the 25th day of August A. D. 1887 at 6 o'clock P. M., and that the same was duly recorded in Book 12 of Deeds on page 101.
 By *[Signature]*
 Register of Deeds.

This plat document is an UNOFFICIAL copy of a Subdivision Plat or Registered Land Survey and is made available for information purposes only.
 To obtain an official copy please contact the Ramsey County Recorder's Office.

OFFICE OF COUNTY TREASURER, ST. PAUL, MINN.
 AUG 25 1887
 1886 TAX PAID
 F. A. RENE

Taxes Paid and Transfer Entered
 JUL 23 1888
[Signature]
 County Auditor.

CITY TREASURER'S OFFICE
 ST. PAUL, MINN.
 JUN 22 1888
 ASSESSMENTS PAID
[Signature]
 CITY TREAS.