


DRAKE'S RE-ARRANGEMENT OF LOT 4 & PART OF LOTS 5, 9 & 10 Blk 30 St Paul Proper.

SCALE 1 INCH = 40 FEET.

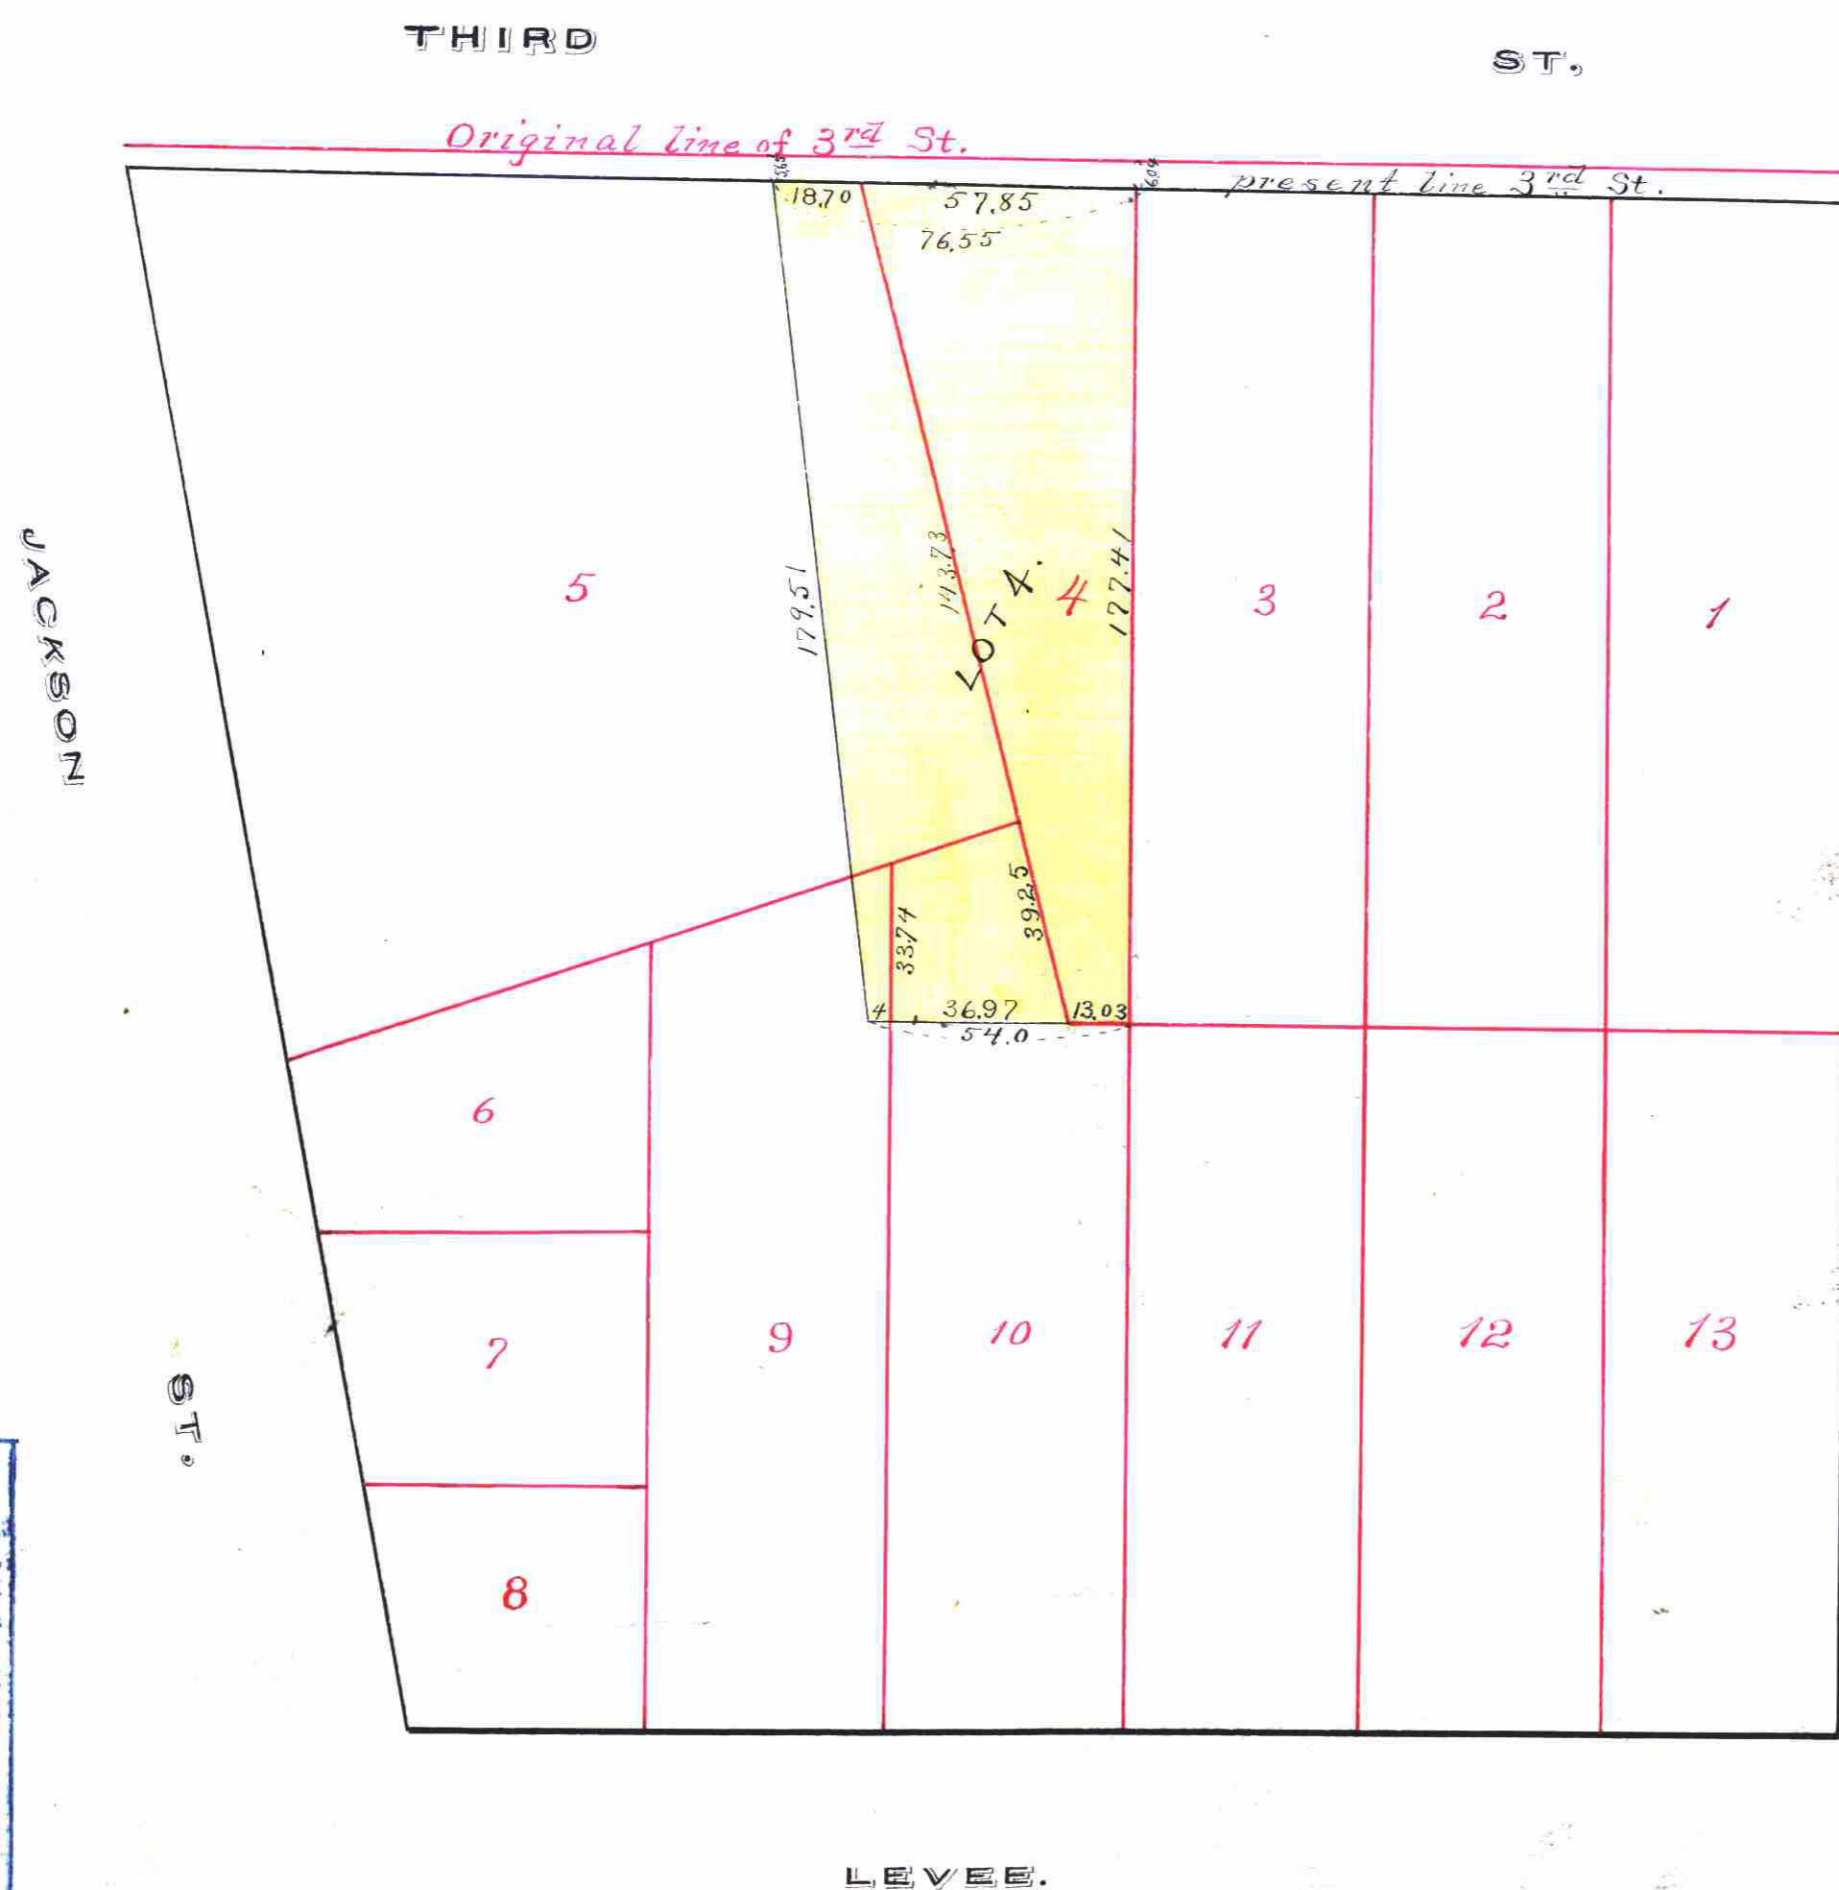

STATE OF MINNESOTA, ss.
County of Ramsey,
Office of the Register of Deeds.
This is to certify that the within
instrument was filed for record
in this office, at St. Paul, on the
20th day of December, D.
1882 at 3 o'clock P.M., and
that the same was duly recorded
in Book W of Plats
By C. H. Hines
Register of Deeds.

St Paul Minn Dec 15th 1882

I certify that this plat correctly represents Block 30 St Paul Proper. - The portion shaded yellow being a correct representation of DRAKE'S Re-Arrangement of Lot 4 and part of Lots 5, 9 and 10 of Block 30 St Paul Proper.
The original lot lines are drawn in red.

D. L. Justice C.D.

We Elias F. Drake and Caroline M. Drake his wife hereby certify that we are the owners of the following described parcel of land viz; Commencing where the southerly line of 3rd St as at present located is intersected by the line between Lots 3 and 4 Block 30 St Paul Proper; Thence southerly along last named line 177.41 feet to the S.E. corner of said Lot 4; Thence westerly parallel with the southerly line of said Block 30.. 54.0 feet; Thence northerly in a direct line 179.51 feet to a point on the southerly line of 3rd St aforesaid 76.55 feet westerly from the point of commencement; Thence easterly along said southerly line of 3rd St 76.55 feet to the point of beginning, and that we have caused the same to be surveyed and plotted as DRAKE'S Re Arrangement of Lot 4 and part of Lots 5, 9 and 10 Block 30 St Paul Proper as hereon indicated by the yellow shading and of the size and dimensions marked hereon. Said Re Arrangement to be hereafter known and designated as Lot 4 Block 30 St Paul Proper.

In witness whereof we have herewith set our hands and seals this 19th day of December AD 1882.
In Presence of
Elias F. Drake
Caroline M. Drake
Elias F. Drake
Caroline M. Drake

State of Minnesota } ss. Be it KNOWN That on this 19th day of Decr AD 1882
County of Ramsey. } before me personally came Elias F. Drake and Caroline M. Drake his wife to me known to be the identical persons described in and who executed the foregoing instrument and who acknowledged that they executed the same freely and voluntarily for the uses and purposes therein expressed.

Taxes paid & Transfer Entered
Nov 29th 1882
J. M. Hardy
County Auditor
James Starkey
S. J. Johnson
Notary Public
Ramsey Co. Minn.
Plat
Commission.

Examined and approved this 2nd day of January 1883
L. W. Rundlett City Engineer

Accepted by the City Council Jan 23rd 1883
W. H. August City Clerk.

City Treasurer's Office,
ST. PAUL, MINN.
RECEIVED
JAN 23 1883
W. H. August
City Clerk