


DYER'S RE-ARRANGEMENT OF BLOCKS. HAMLINE SYNDICATE NO. 3.

ST. PAUL, MINN.
JOHN B. IRVINE, SURVEYOR.

395668 112

APRIL, 1910.

SCALE 40 ft. per. inch.

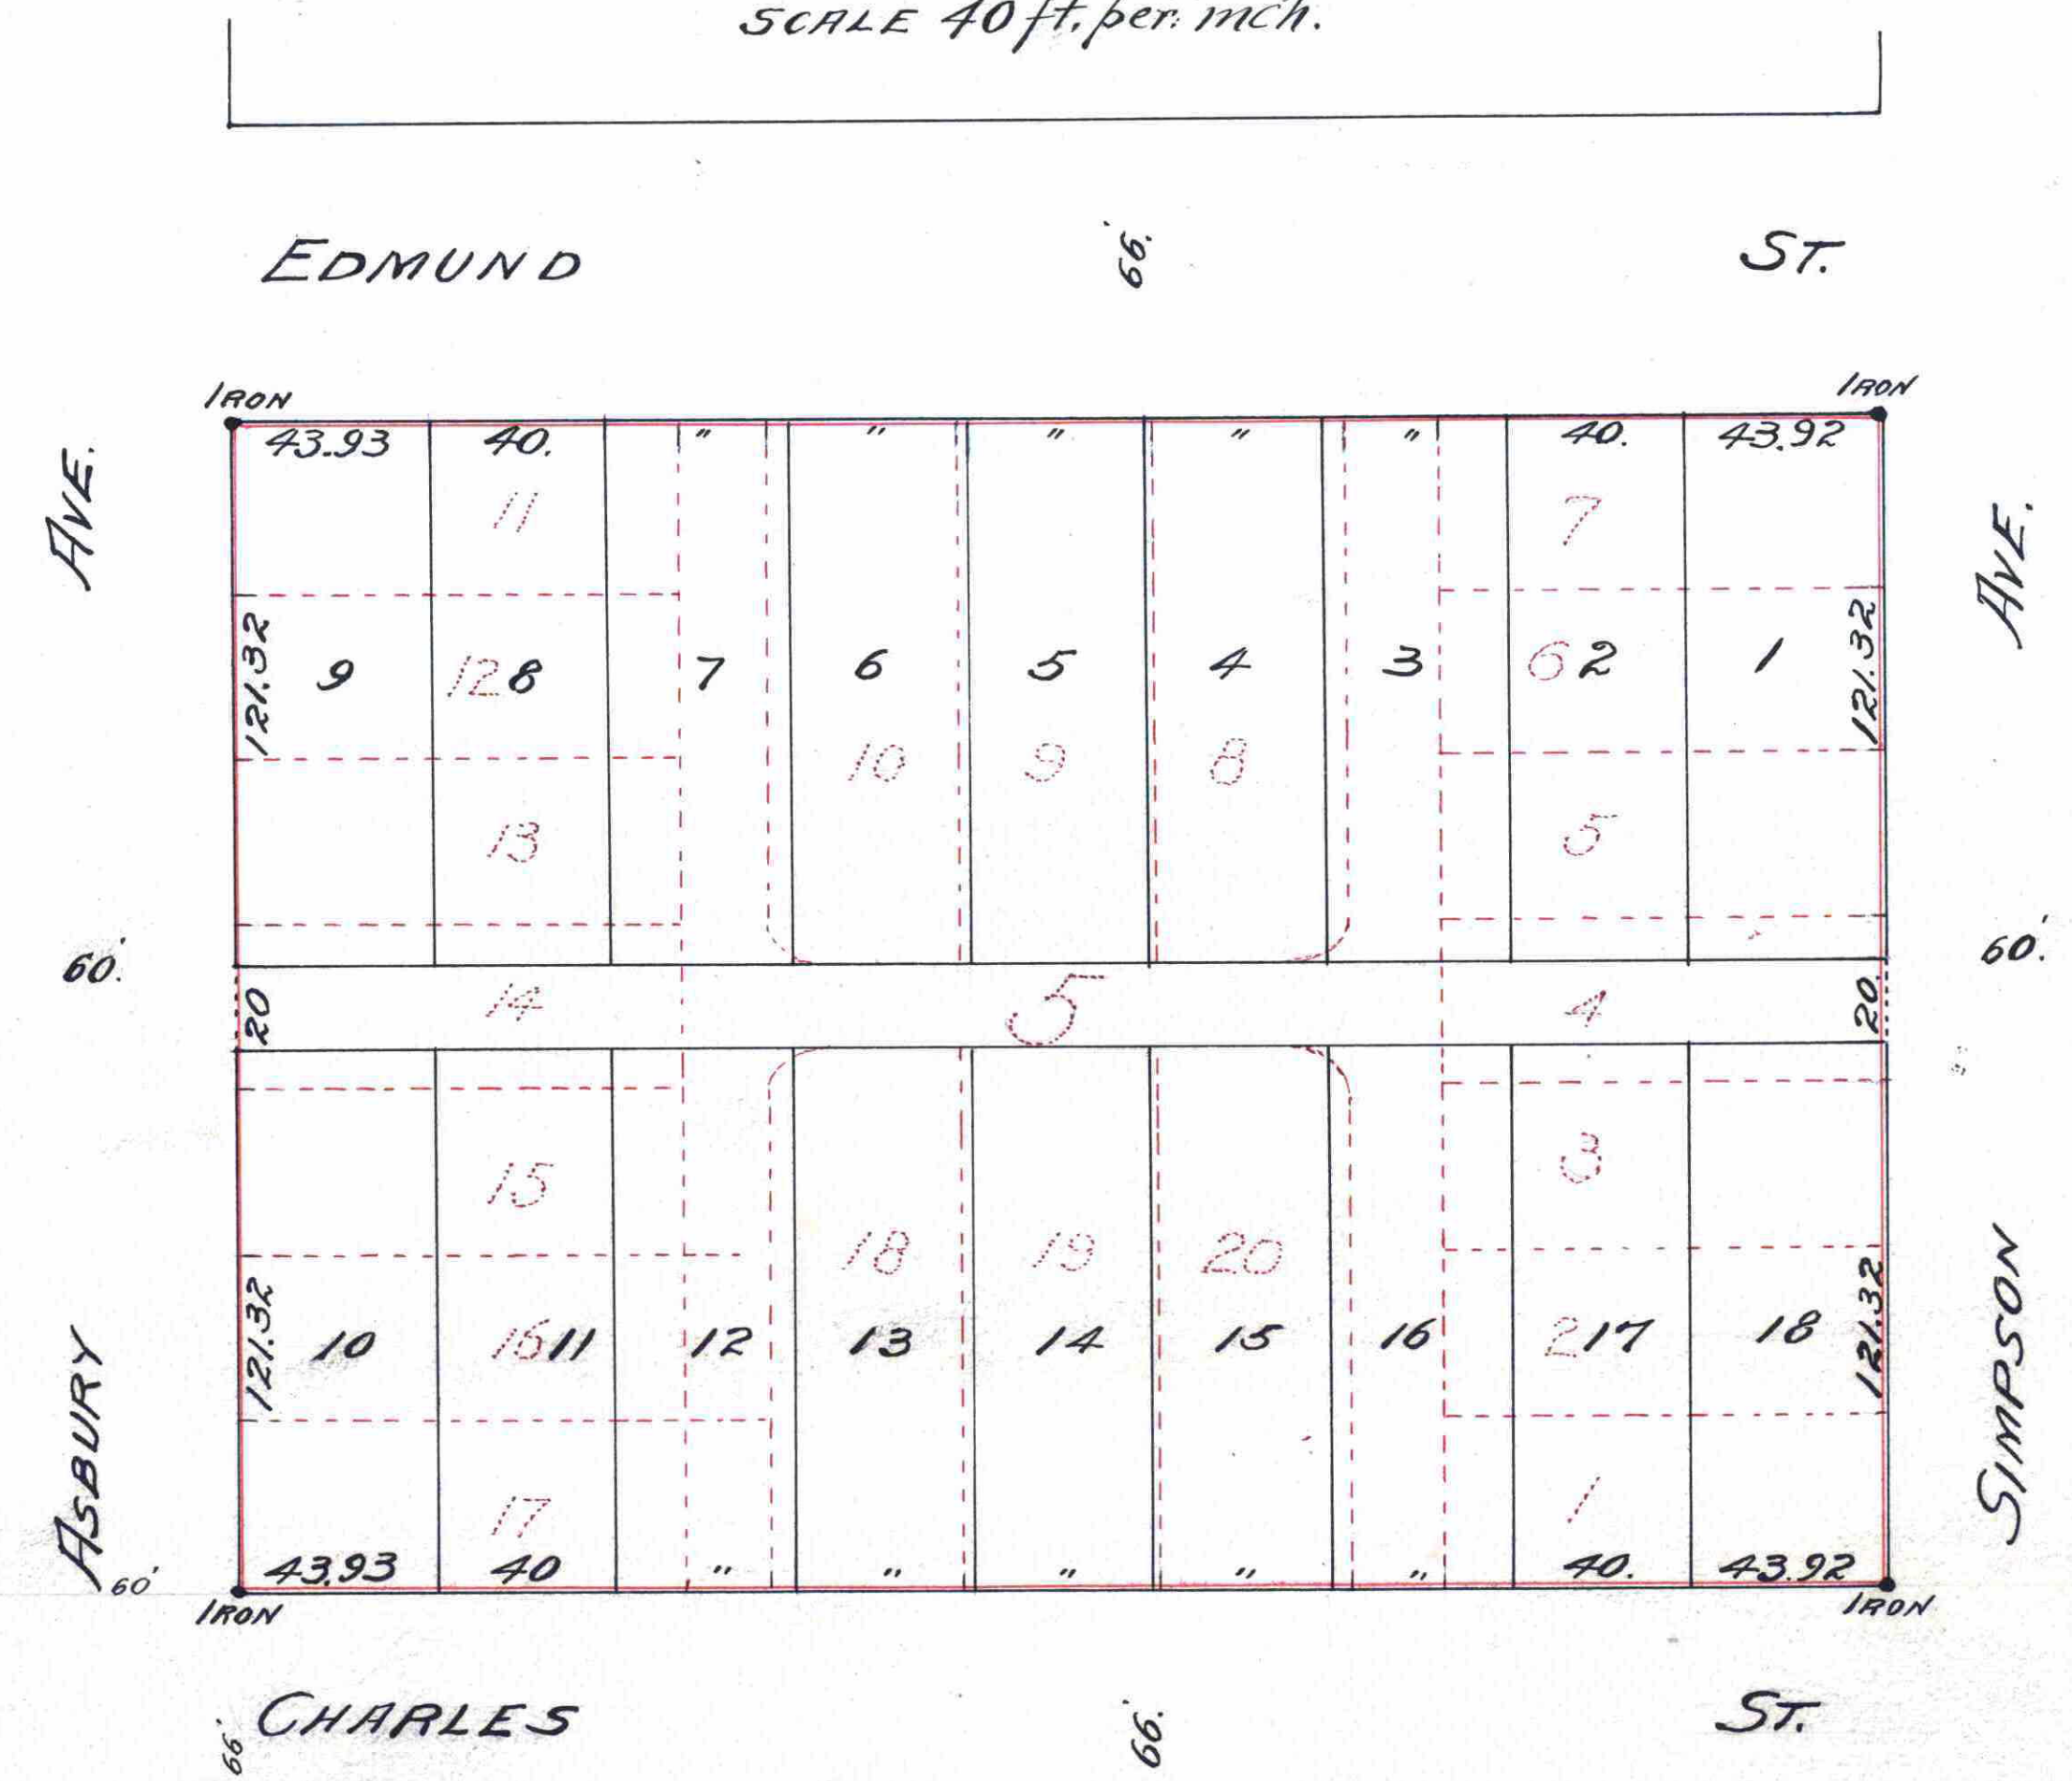

I hereby certify to having surveyed and platted the property as described on this map as Dyer's Re-arrangement of Block 5 Hamline Syndicate No. 3. and have placed iron monuments at the corners thereof as shown on this map and the same is correct.

John B. Irvine
Surveyor.

State of Minnesota } On this 18th day of May A.D. 1910 personally
County of Ramsey } appeared before me the undersigned John B. Irvine
to me well known, and acknowledged that he executed the foregoing
certificate as his own free act and deed.

O. E. Holman
Notary Public.
Ramsey Co. Minn.

My Commission Expires Dec. 10th 1913

This is to certify that De Witt C. Dyer and Nane J. Dyer his wife are the owners of lots 1 to 20 inclusive, in Block 5 Hamline Syndicate No. 3. have caused the same to be surveyed and platted, and hereafter known as Dyer's Re-arrangement of Block 5 Hamline Syndicate No. 3. as shown by this plat, and hereby dedicate to the public and for the public use forever all the streets, avenues or alleys as herein indicated. Witness our hands and seals this 23rd day of May A.D. 1910.

In presence of
De Witt C. Dyer
Nane J. Dyer

State of Minnesota } On this 23rd day of May A.D. 1910.
County of Houston } personally came before me the undersigned
De Witt C. Dyer and Nane J. Dyer his wife to me well known and
they acknowledged that they executed the foregoing certificate as their
own free act and deed.

Notary Public.
Houston Co. Minn.

Accepted and Approved this Tenth day of September A.D. 1910.

Plat Commission.
City Engineer.

Accepted by the Board of Aldermen Sept 21 A.D. 1910.
Accepted by the Assembly Sept 15 - A.D. 1910.
Approved Sept 27 - 1910
Geo. J. Huntington
City Clerk.

STATE OF MINNESOTA
County of Ramsey.
Office of the Register of Deeds.
This is to certify that the within instrument was filed for record in this office on the 27th day of September A. D. 1910, at 10 o'clock A. M., and that the same has duly been recorded in Book of Records Page 15
M. J. Quinn
Register of Deeds.

Alleys shown by dotted lines vacated by Common Council Aug. 24 1910.
Recorded Sep. 9 1910.

Taxes for the year 1909 on the lands described herein paid.
SEP 30 1910
ST. PAUL, MINN.
JESSE M. LANDRY Treasurer.
Per [Signature]

TAXES PAID
AND TRANSFER ENTERED
OCT - 3 1910
EDW. G. KRAMER, Co. Auditor,
By [Signature] Deputy.

CITY TREASURER'S OFFICE,
ST. PAUL, MINN.
OCT 3 1910
Assessment Paid
S. A. BOWDITCH
By [Signature]

899568