

# DENSLOW'S

## Re-arrangement of

Lots 5,6,7,8,9,10,11,12 Block 2. Lots 9,10,11,12,13,14,15,16,17,18,19 Block 3. and Lot 11, Block 4.

CRUICKSHANKS GARDEN LOTS

### St Paul

WE HEREBY CERTIFY TO HAVING SURVEYED & PLATTED THE PROPERTY AS DESCRIBED ON THIS MAP AS DENSLOW'S REARRANGEMENT OF LOTS 5,6,7,8,9,10,11,12, BLOCK 2, LOTS 9,10,11,12,13,14,15,16,17,18,19, BLOCK 3, & LOT 11, BLOCK 4, CRUICKSHANKS GARDEN LOTS ST. PAUL, AND HAVE PLACED IRON MONUMENTS AT THE CORNERS OF EACH AND EVERY BLOCK AS SHOWN ON THIS MAP, AND THE SAME IS CORRECT.


*T. F. Nicholl & Son*  
SURVEYORS.

STATE OF MINNESOTA }  
COUNTY OF RAMSEY } SS.

ON THIS 17<sup>th</sup> DAY OF June A.D. 1889 PERSONALLY APPEARED BEFORE THE UNDERSIGNED THOS. F. NICHOLL, ONE OF THE FIRM OF T. F. NICHOLL & SON, TO ME WELL KNOWN AND ACKNOWLEDGED THAT HE EXECUTED THE FOREGOING CERTIFICATE AS HIS OWN FREE ACT AND DEED.

*Frank P. McAuley*  
NOTARY PUBLIC  
RAMSEY CO. MINN.

TAXES.

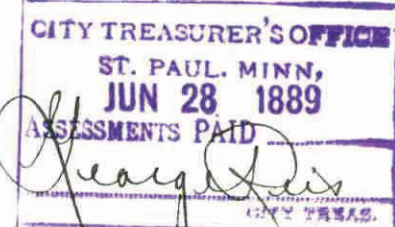


Taxes Paid and Transfer Entered

JUL 3 1889

M. F. KAIN, County Auditor.

Per *Mossbrugger*

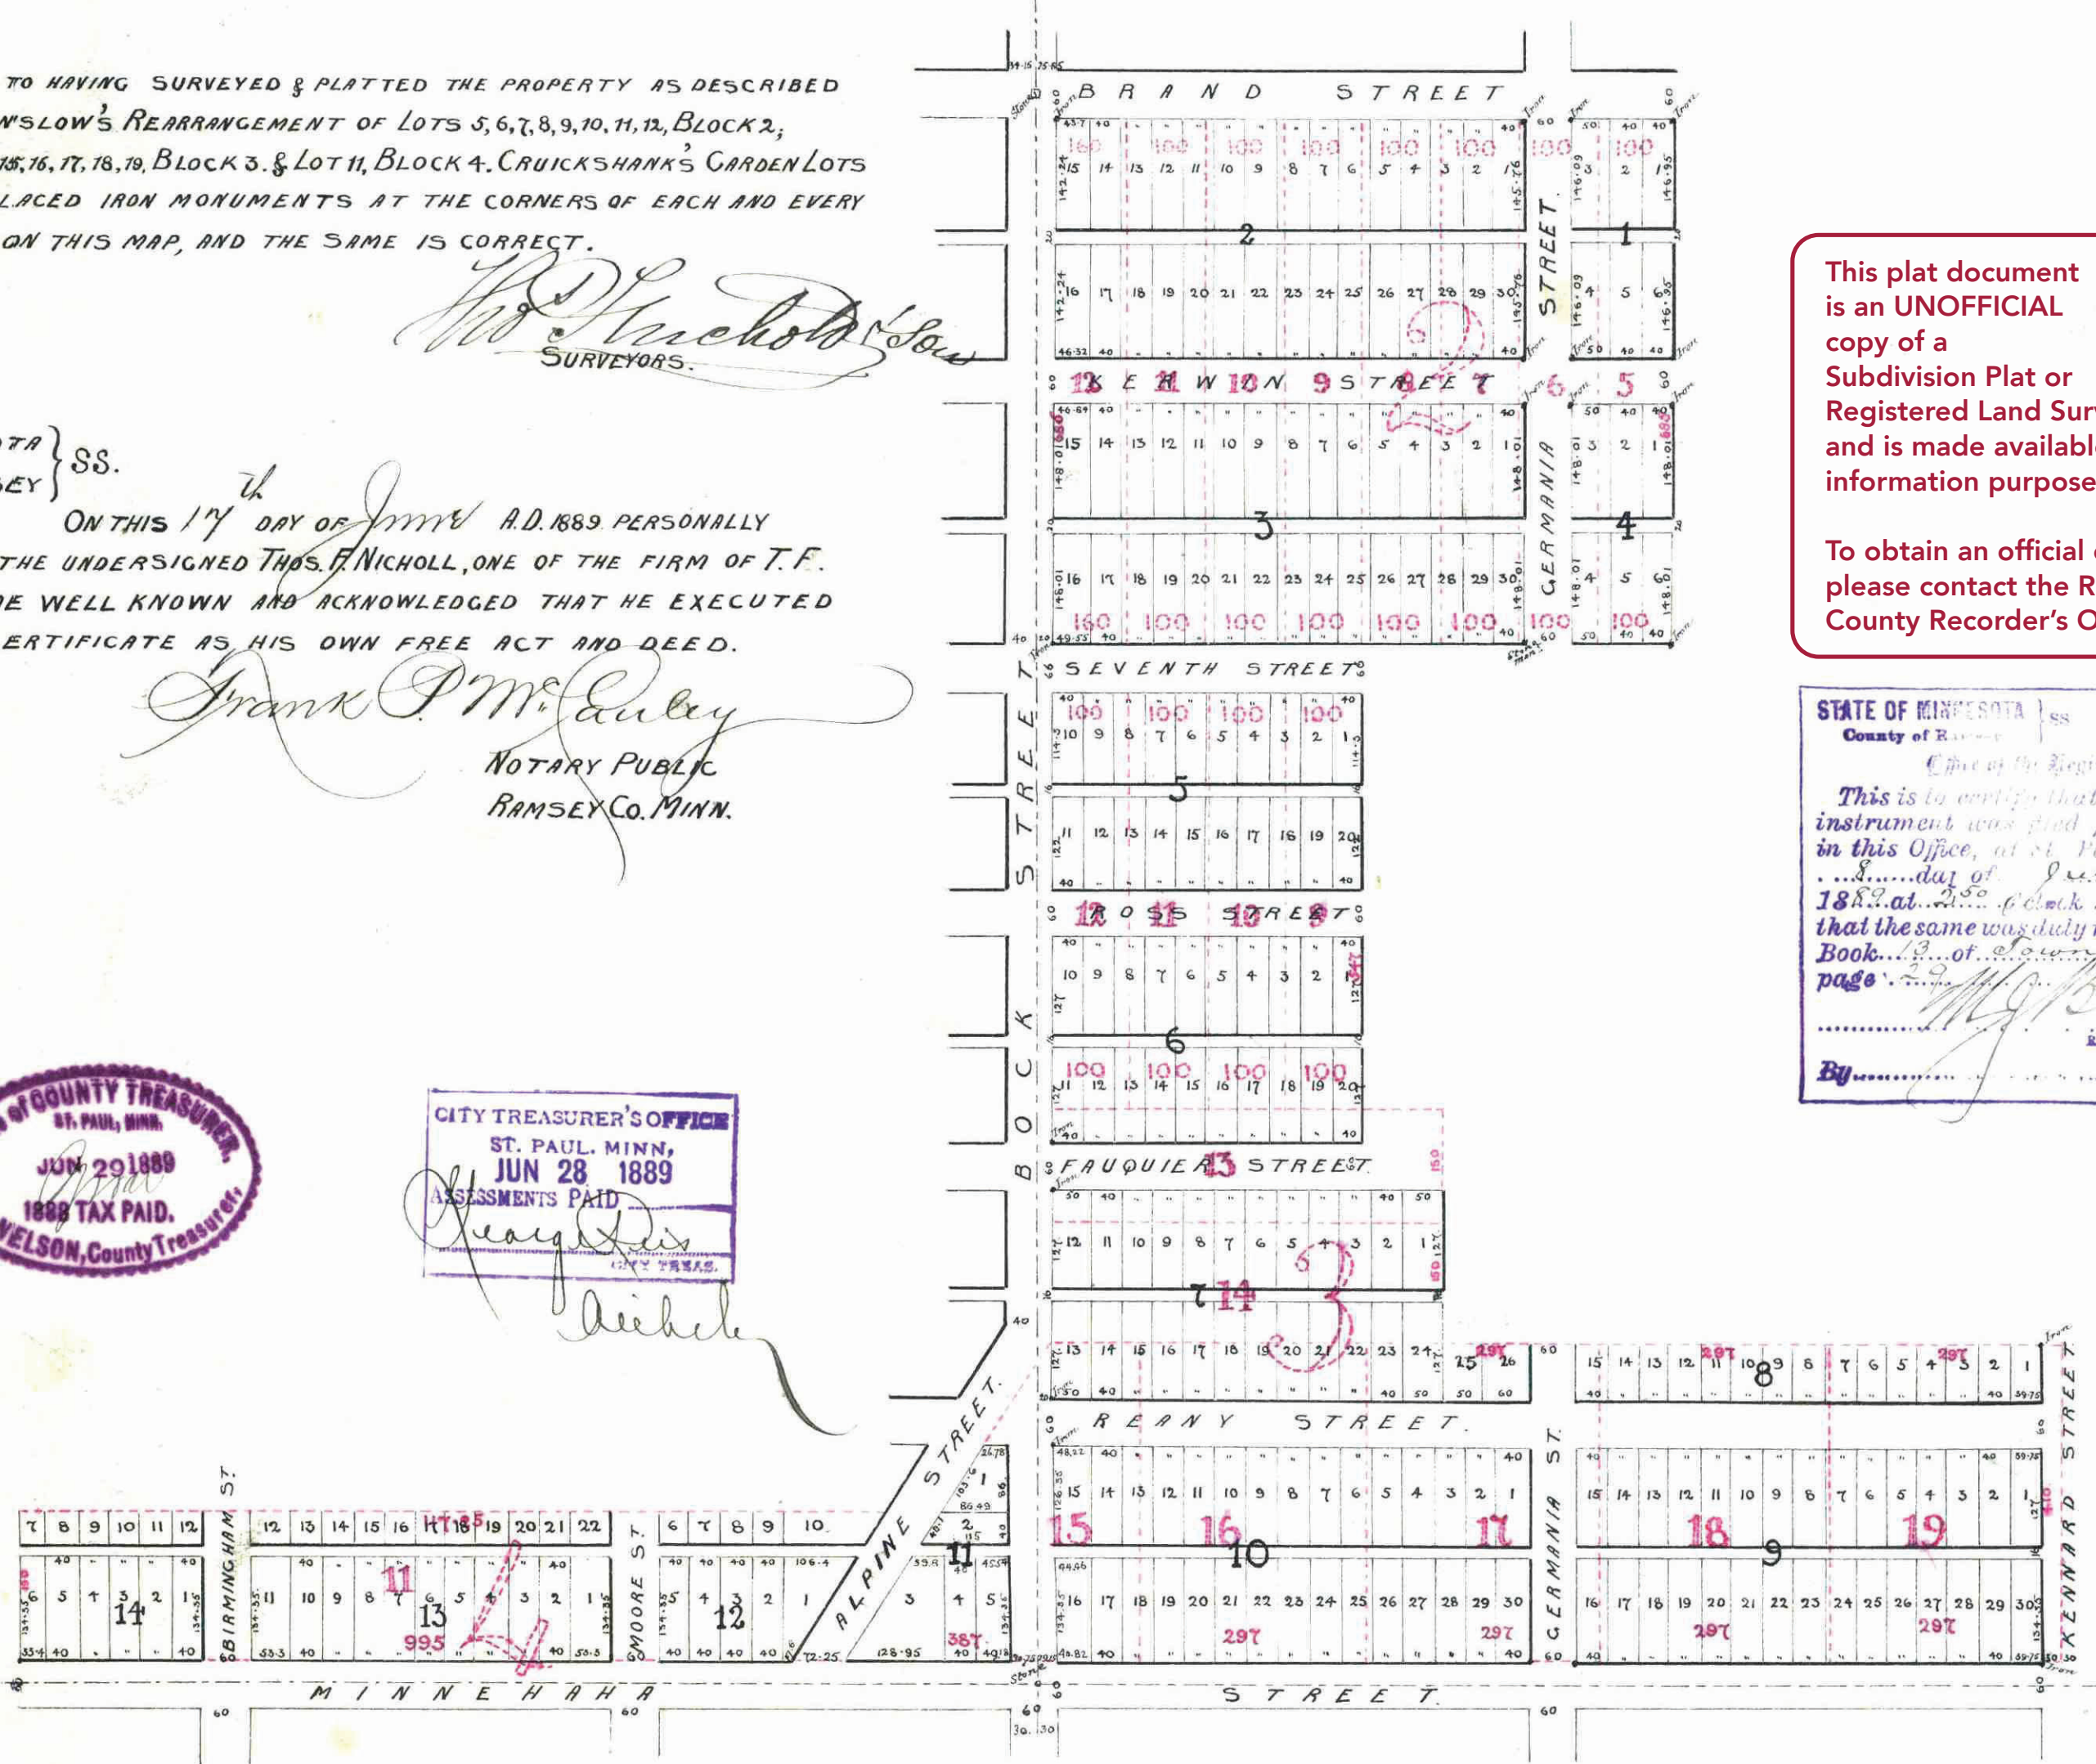

This plat document is an UNOFFICIAL copy of a Subdivision Plat or Registered Land Survey and is made available for information purposes only.

To obtain an official copy please contact the Ramsey County Recorder's Office.

STATE OF MINNESOTA }  
COUNTY OF RAMSEY }  
This is to certify that the within instrument was filed for Record in this Office, at St. Paul, on the 18<sup>th</sup> day of June A. D. 1889 at 11 o'clock A. M., and that the same was duly recorded in Book... of... page...  
By *McCall*  
Recorder

ACCEPTED AND APPROVED THIS 19<sup>th</sup> DAY OF June A.D. 1889.

*W. H. Russell* } PLAT COMMISSION.  
*J. H. ...*

ACCEPTED BY THE COMMON COUNCIL OF THE CITY OF ST. PAUL ON THE 18<sup>th</sup> DAY OF June 1889.

*Thos. F. Nicholl*  
CITY CLERK.

THIS IS TO CERTIFY THAT ELLA B. LAWTON AND GEORGE O. LAWTON HER HUSBAND, EDWARD G. ROGERS AND MARY M. ROGERS HIS WIFE, GEORGE V. BACON AND GARRIE A. BACON HIS WIFE, PROPRIETORS OF LOTS 5, 6, 7, 8, 9, 10, 11, 12, BLOCK 2, LOTS 9, 10, 11, 12, 13, 14, 15, 16, 17, 18, 19, BLOCK 3, AND LOT 11, BLOCK 4, OF CRUICKSHANKS GARDEN LOTS HAVE CAUSED THE SAME TO BE SURVEYED & PLATTED AND HEREAFTER KNOWN AS DENSLOW'S REARRANGEMENT OF LOTS 5, 6, 7, 8, 9, 10, 11, 12, BLOCK 2, LOTS 9, 10, 11, 12, 13, 14, 15, 16, 17, 18, 19, BLOCK 3, AND LOT 11, BLOCK 4, CRUICKSHANKS GARDEN LOTS AS SHOWN BY THIS PLAT, AND HEREBY DEDICATE TO THE PUBLIC, AND FOR THE PUBLIC USE FOR EVER, ALL THE STREETS, AVENUES AND ALLEYS AS HEREIN INDICATED.

WITNESS OUR HANDS AND SEALS, THIS 17<sup>th</sup> DAY OF June 1889.  
IN PRESENCE OF  
*Edward G. Rogers*  
*Mary M. Rogers*  
*Geo. V. Bacon*  
*Charlie A. Bacon*

STATE OF MINNESOTA }  
COUNTY OF RAMSEY } SS.  
ON THIS 17<sup>th</sup> DAY OF June A.D. 1889, PERSONALLY APPEARED BEFORE THE UNDERSIGNED ELLA B. LAWTON & GEORGE O. LAWTON, EDWARD G. ROGERS & MARY M. ROGERS, GEORGE V. BACON & GARRIE A. BACON, TO ME WELL KNOWN, AND ACKNOWLEDGED THAT THEY EXECUTED THE FOREGOING CERTIFICATE AS THEIR OWN FREE ACT & DEED.

*Frank McAuley*  
NOTARY PUBLIC  
RAMSEY COUNTY, MINN.