


PEASE'S RE-AR. OF LOTS 3-4-7-8 OF

HILL

BY
OFFICE OF THE COUNTY ENGINEER
RAMSEY COUNTY
MINN.
PAUL N. COATES
COUNTY ENGINEER

Being the N.E. 1/4 of the SW 1/4 of Sec. 17-Twp. 29N-R. 23W
Note: Black figures indicate measurements on original plat.
Red figures indicate measurements on re-survey
by Ramsey County Surveyor, dated Sept 27th 1923

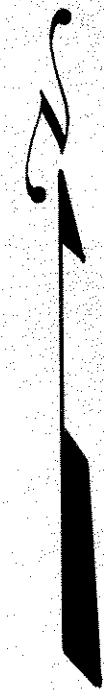

PEASE'S RE.
 OF LOT S 3, 4, 7 AND 8
PROSPECT HILL
 BEING THE N.E. 1/4 OF S.W. 1/4 SEC. 17 T. 29 R. 23
ROSE TOWNSHIP
RAMSEY CO. MINN.
 SCALE 100 FT. = 1 INCH

James E. Egan Surveyor 1885

• indicates iron monuments

