

# HAAS AND WACHENHEIMERS' ADDITION

TO THE CITY OF ST. PAUL. 47

Scale, 50 feet to 1 Inch.

I hereby certify to having surveyed and platted the property as described on this map as Haas & Wachenheimers' Addition and have placed iron monuments at the corners of each and every block as shown on this map, and the same is correct.

Charles A. Forbes  
Surveyor

STATE OF MINNESOTA, }  
County of Ramsey, }

On this twenty fourth day of September A. D. 1887, personally appeared before the undersigned, CHARLES A. FORBES, (to me well known) and acknowledged that he executed the foregoing Certificate as his own free act and deed.

Edward G. Henry  
Notary Public, Ramsey Co., Minn.

This is to certify that Morris M. Wachenheimer and Gussie Wachenheimer his wife Quincy Haas and Emma Haas his wife proprietors of Lots 12345678 Block 1 Kiefer, Schurmeier & Wilds Subdivision of Lots 1245 Collings' Out Lots to St. Paul, Ramsey County have caused the same to be surveyed and platted, and hereafter known as Haas & Wachenheimers' Addition to the City of St. Paul as shown by this plat, and hereby dedicates to the public, and for the public use forever, all the Streets, Avenues, Alleys, Parks and Boulevards, as herein indicated.

Witness our hands and seals, this 24 day of September 1887.  
In presence of  
M. Wachenheimer (Seal)  
Quincy Haas (Seal)  
Emma Haas (Seal)  
E. G. Henry

State of Minnesota, }  
County of Ramsey, }  
On this twenty fourth day of September A. D. 1887, personally came before me, the undersigned, Morris M. Wachenheimer and Gussie Wachenheimer his wife, Quincy Haas and Emma Haas his wife to me well known, and they acknowledged that they executed the foregoing Certificate for the uses and purposes therein expressed.

Edward G. Henry  
Notary Public,  
Ramsey County, Minn.

Accepted and approved this 28 day of September A. D. 1887.  
M. A. Haublyke  
W. H. Jewell  
Plat Commissioners.  
H. W. Remondet  
at 290.

Accepted by the Common Council of the City of St. Paul, on the First day of October 1887.  
John A. Gandy  
City Clerk.

By Just. J. J. [Signature]  
Deputy

This plat document is an UNOFFICIAL copy of a Subdivision Plat or Registered Land Survey and is made available for information purposes only.

To obtain an official copy please contact the Ramsey County Recorder's Office.



No. 93778


STATE OF MINNESOTA }  
County of Ramsey, }

Office of the Register of Deeds.

This is to certify that the within instrument was filed for Record in this Office, at St. Paul, on the 24 day of September A. D. 1887, at 10 o'clock A. M., and that the same is duly recorded in Book 13 of 2 pages.

By [Signature]  
Register of Deeds.

ATLANTIC ST

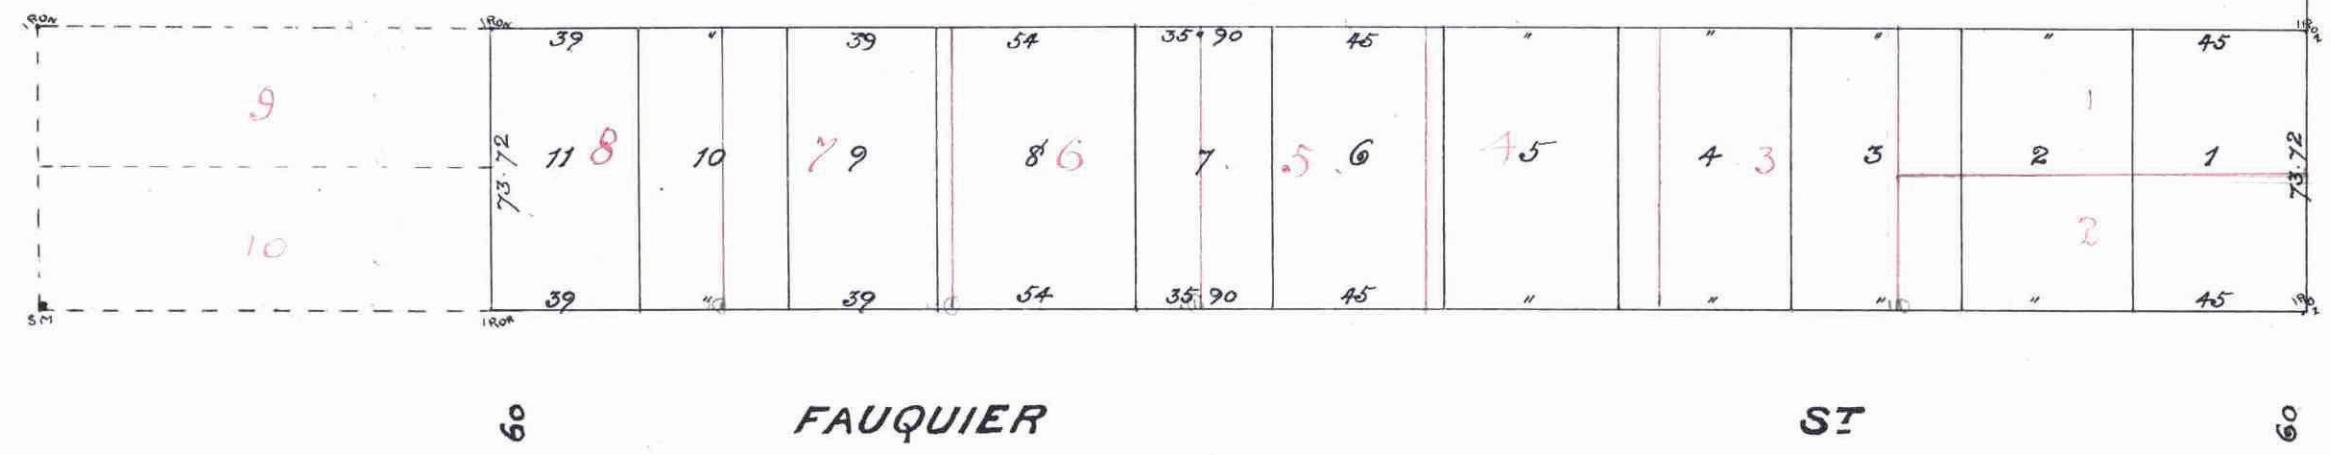

ENGLISH ST

CITY TREASURER'S OFFICE  
ST. PAUL, MINN.  
OCT 10 1889  
ASSESSMENTS PAID  
[Signature]  
CITY TREAS.

OFFICE OF COUNTY TREASURER  
ST. PAUL, MINN.  
OCT 10 1889  
1888 TAX PAID.  
A. H. NELSON, County Treasurer  
[Signature]

Taxes Paid and Transfer Entered  
OCT 11 1889  
M. F. KAIN, County Auditor.  
[Signature]