


This plat document is an UNOFFICIAL copy of a Subdivision Plat or Registered Land Survey and is made available for information purposes only.

To obtain an official copy please contact the Ramsey County Recorder's Office.

STATE OF MINNESOTA, ss.  
 County of Ramsey,  
 OFFICE OF THE REGISTER OF DEEDS.  
 This is to certify that the within instrument was filed for Record in this office, at St. Paul, on the 13th day of June, A. D. 1885 at 10 o'clock A. M., and that the same was duly recorded in Book X of Plate pages 23

By R. A. Kelly Register of Deeds.  
 Deputy.

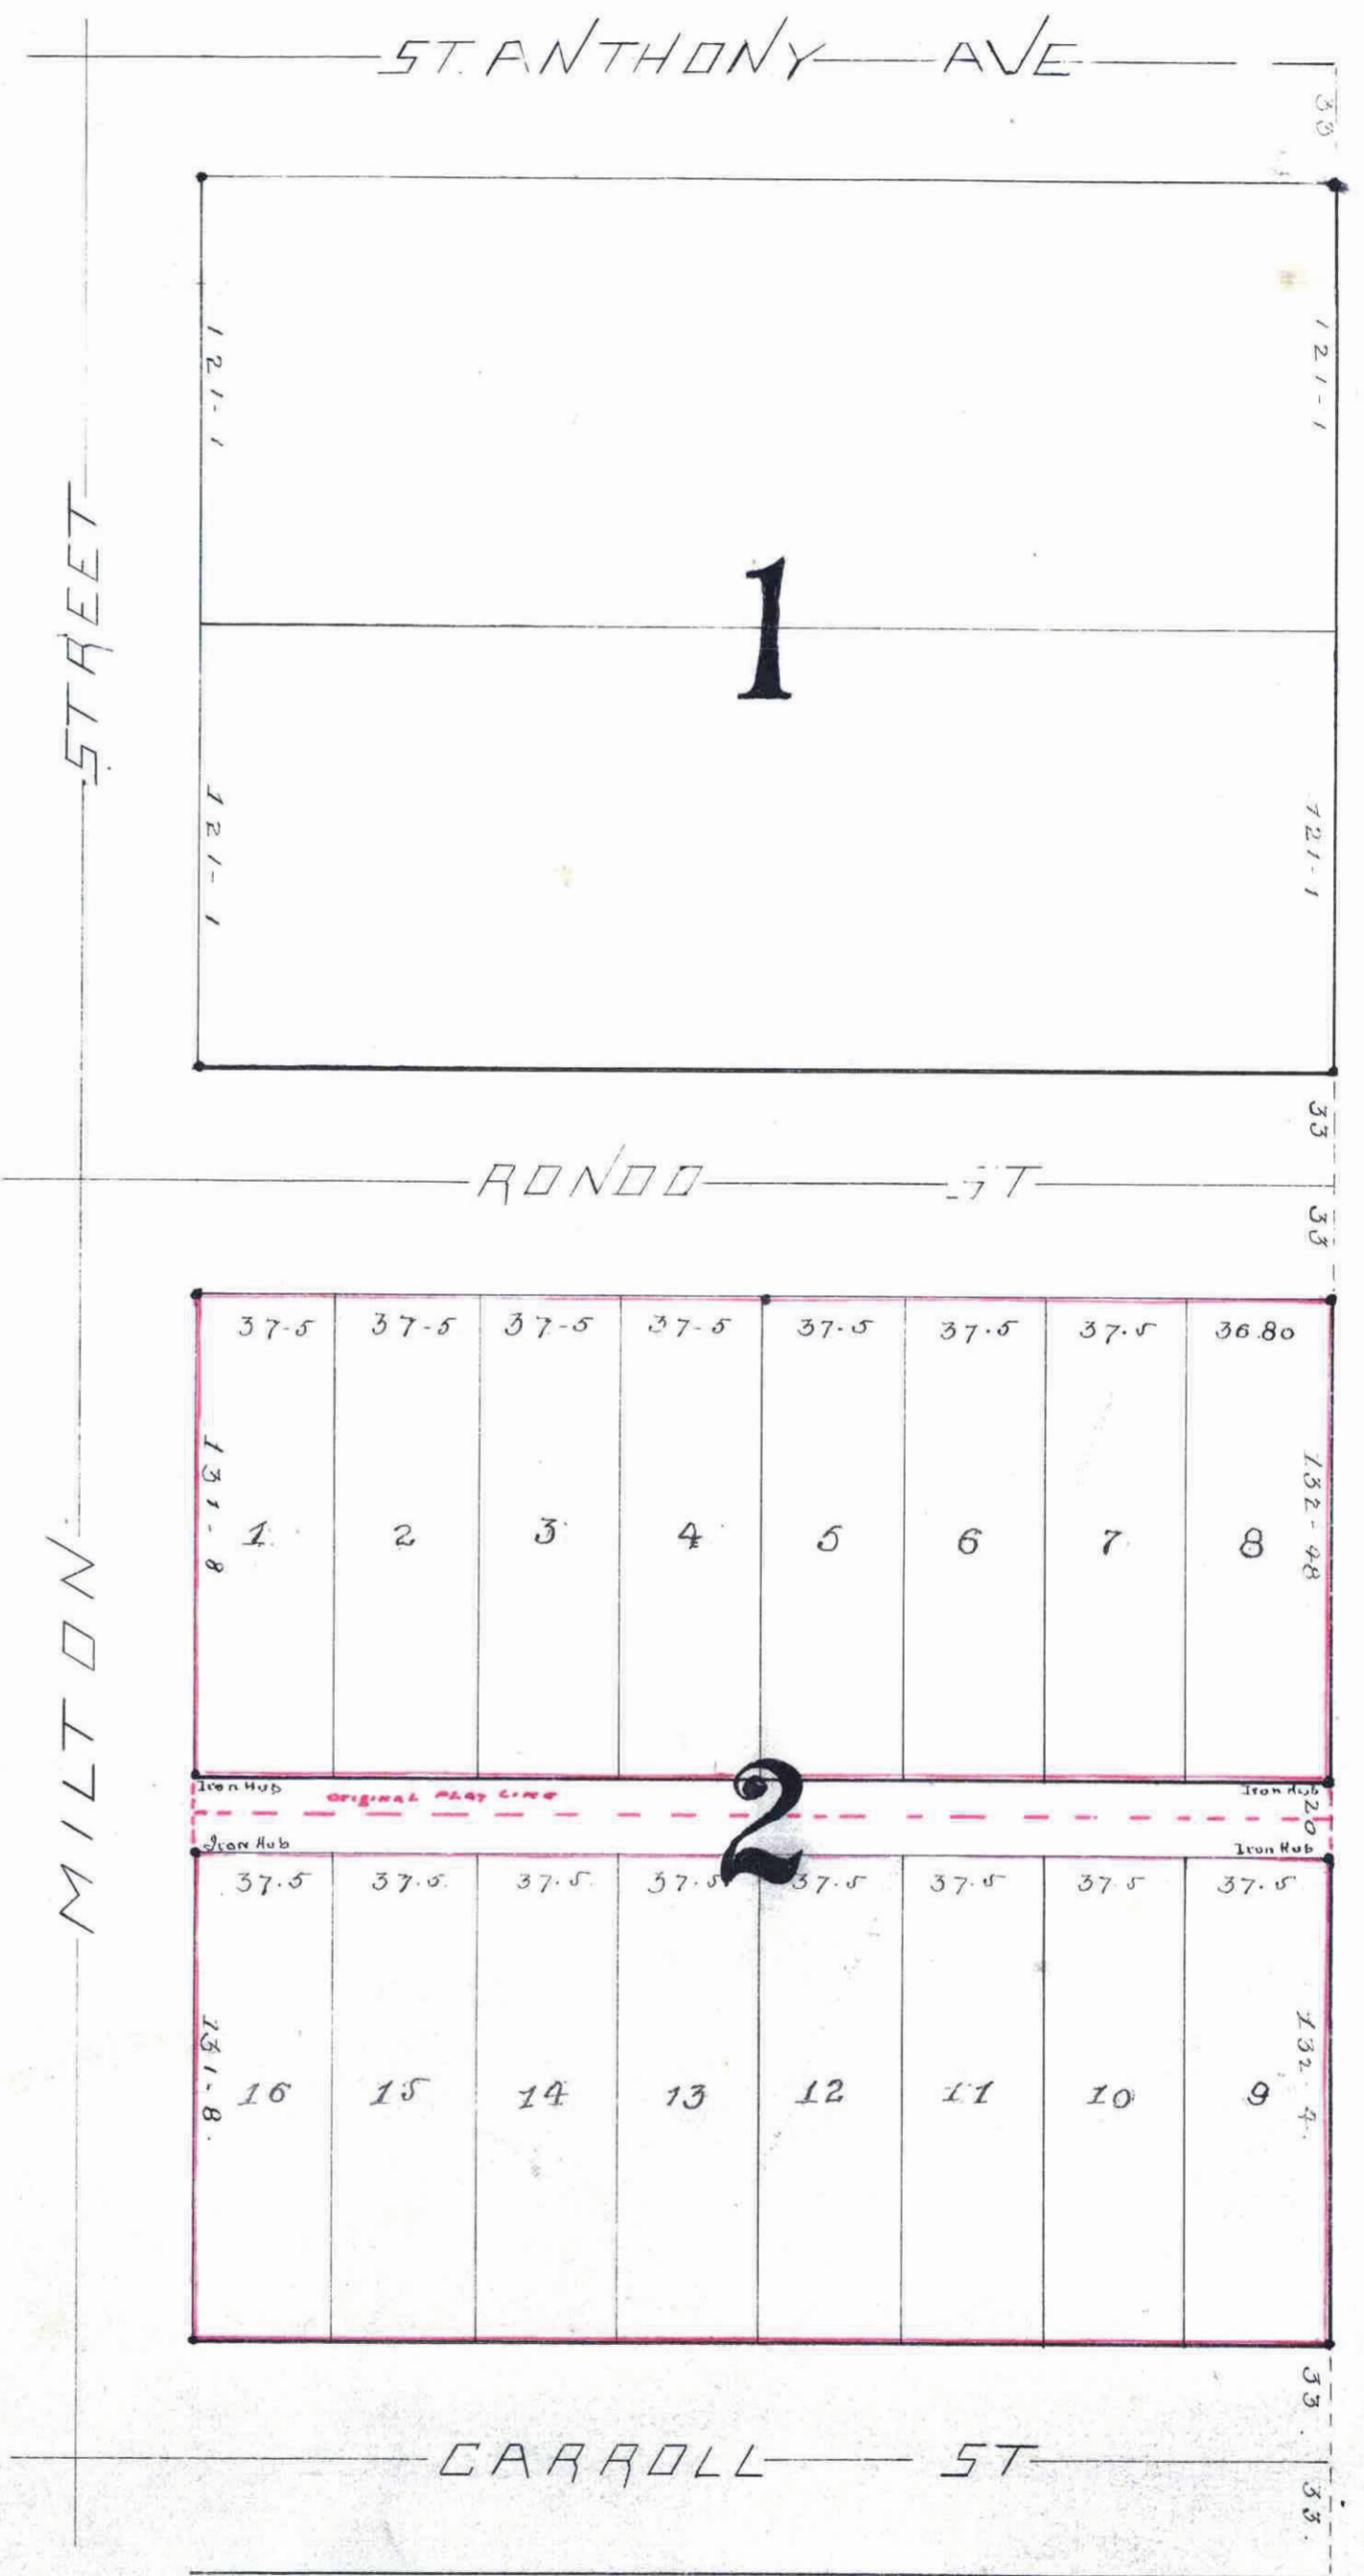

I  
 I hereby certify to having surveyed and platted the property as described on this map as J. W. Fallihee's rearrangement of Block 2 of E. G. Rogers' 2d Addition and have placed even monuments at the corners of each and every block as shown on this map and the same is correct.

Chas. A. Forbes  
 SURVEYOR

II  
 STATE OF MINNESOTA } On this 2th day of May AD 1885 personally came before me the undersigned Chas. A. Forbes  
 County of Ramsey } to me well known and acknowledged that he executed the foregoing certificate as shown per act and deed.

Notarial Seal  
Thos. O'Brien  
 NOTARY PUBLIC,  
 Ramsey Co. MINN.

III  
 This is to certify that J. W. Fallihee and Mary E. Fallihee proprietors of the following described property being the W 1/2 of the N 1/2 of the E 1/2 of the S W 1/4 of the S W 1/4 of Section 35 Township 29 Range 23 and have caused the same to be surveyed and platted and hereafter known as J. W. Fallihee's rearrangement of Block 2 of E. G. Rogers' Second Addition to the City of St. Paul as shown by this plat and hereby dedicate to the public and for the public use forever, all the streets, avenues, alleys, paths and boulevards as herein indicated. Witness our hands and seals this 12th day of May 1885.

In presence of: John D. O'Brien }  
Thos. O'Brien }  
J. W. Fallihee }  
Mary E. Fallihee }

IV  
 STATE OF MINNESOTA } On this 14th day of May AD 1885 personally came before me the undersigned John D. O'Brien  
 County of Ramsey } to me well known and they acknowledged that they executed the foregoing certificate for the uses and purposes therein expressed and as herein set out and did.

Notarial Seal  
Thos. O'Brien  
 NOTARY PUBLIC  
 Ramsey Co. MINN.

V  
 Accepted and approved this 21st day of May AD 1885.

S. J. Tolson  
J. W. Starkey  
 PLAT COMMISSIONERS.

VI  
 I hereby recommend the acceptance of the within plat by the common Council

VII  
 Accepted by the common council of the City of Saint Paul on the 26th day of May 1885.

L. W. Rundlett  
 CITY ENGINEER  
 CITY CLERK

VIII  
 Taxes paid

XI  
 Assessments paid, June 13th 1885

James O'Brien  
 County Auditor,  
 Ramsey Co. MINN.  
Geo. W. Angley Deputy  
George R. ...  
 CITY TREASURER  
 SAINT PAUL