


AUDITOR'S SUBDIVISION No. 78

RAMSEY CO. MINN.

Scale: 1 in = 200 ft.

June 1932

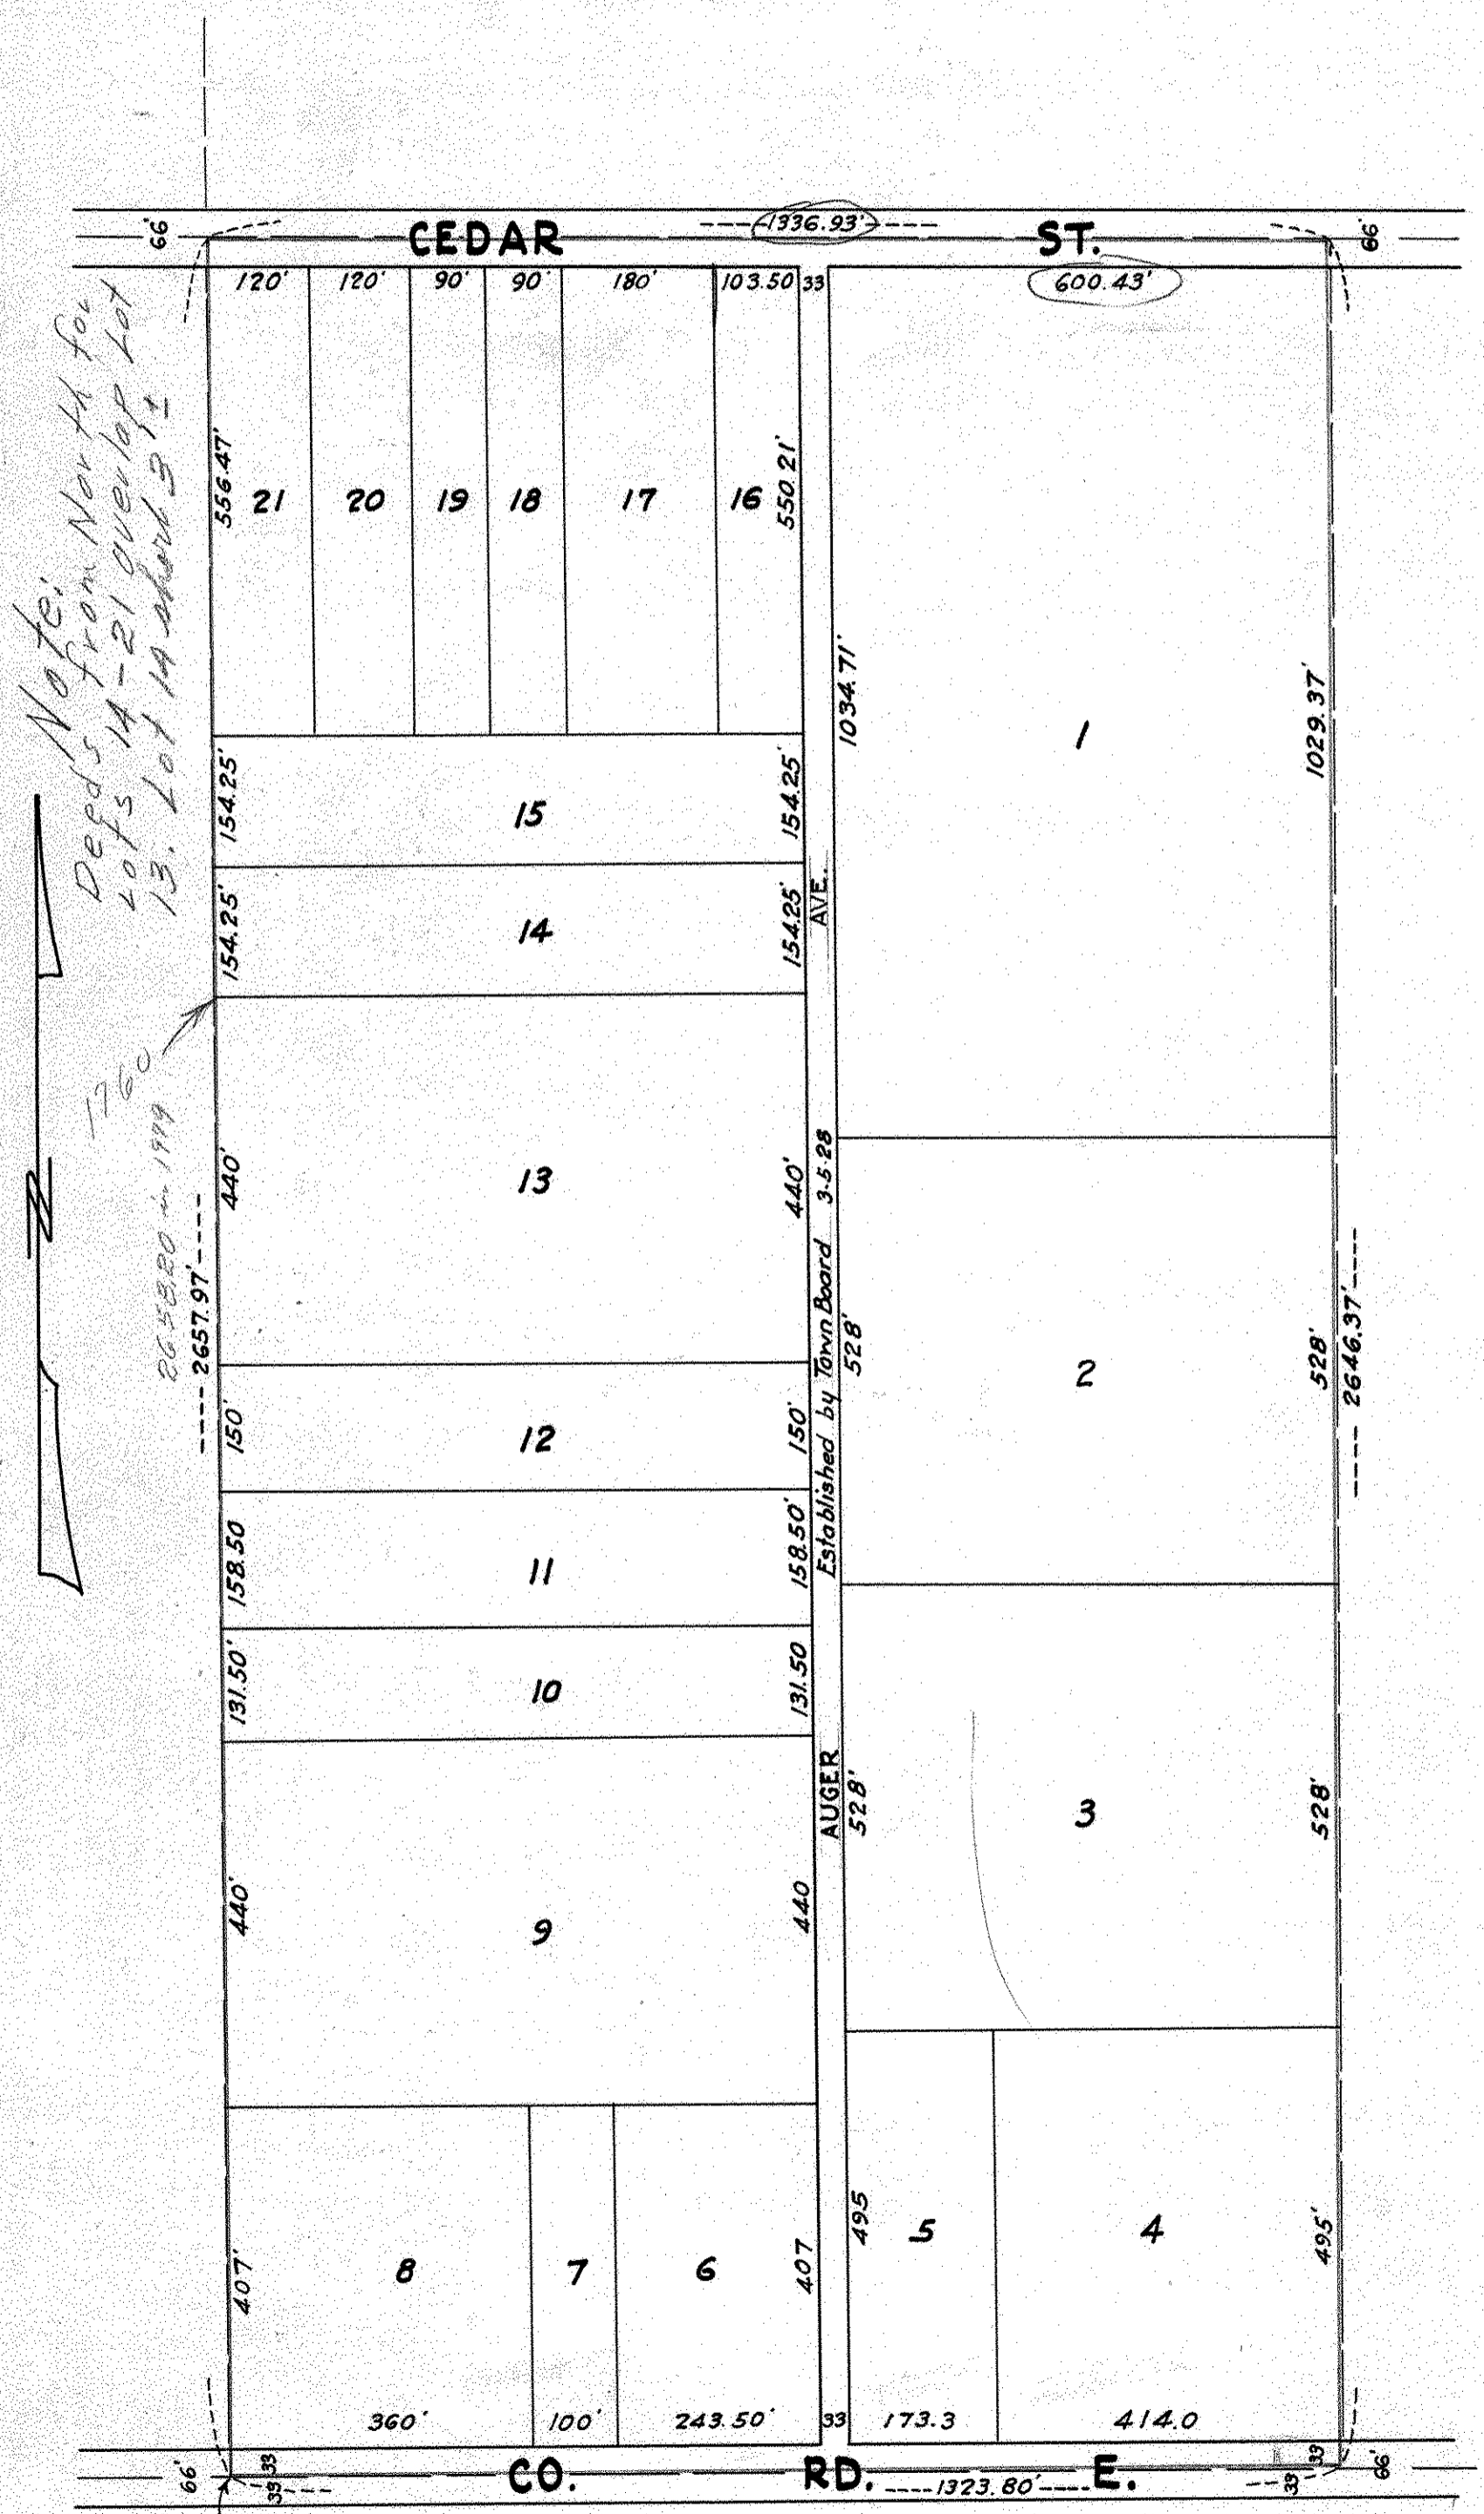

I, Paul N. Coates, County Surveyor of Ramsey County, Minnesota, hereby certify to having platted the property as described on this map upon request and by order of the County Auditor as Auditor's Subdivision No. 78, Ramsey Co. Minn., and the same is correct in accordance with records of Register of Deeds.

Paul N. Coates
COUNTY SURVEYOR

STATE OF MINNESOTA } On this 20th day of June A.D. 1932 personally appeared
COUNTY OF RAMSEY } before me Paul N. Coates, County Surveyor of Ramsey County, to
me well known, and acknowledged that he executed the foregoing certificate as his own
free act and deed.

L. N. Palmer
Notary Public, Ramsey Co. Minnesota
My Commission Expires Aug. 7 1936

STATE OF MINNESOTA } I, Geo. J. Ries, County Auditor of the County and State aforesaid do
COUNTY OF RAMSEY } hereby certify that in compliance with, and according to the pro-
visions of Section 2219, Mason's Minnesota Statutes for 1927, I have as such County Auditor
caused the following described tract of land to wit: The W. 1/2 of the S-W 1/4 of Section 26,
Twp. 30 N., Rge. 22 W., excepting therefrom Cedar St., Auger Ave., and Co. Rd. E., to be
platted, and hereafter known as Auditor's Subdivision No. 78, Ramsey Co. Minn. as shown
on this map.

Witness my hand and official seal this 21st day of June A.D. 1932.
IN PRESENCE OF:

John F. Sathies
S. C. Ringmaad
Geo. J. Ries
COUNTY AUDITOR

STATE OF MINNESOTA } On this 21st day of June A.D. 1932, personally appeared
COUNTY OF RAMSEY } before me Geo. J. Ries, County Auditor of Ramsey County, to me
well known, and acknowledged that he executed the foregoing certificate as his own
free act and deed.

John F. Sathies
Notary Public, Ramsey Co. Minnesota
My Commission Expires 7/1/1933

Recorded June 21 - 1932