2350

Abstract #1206481

RICHARD'S PARK

VILLAGE OF ROSEVILLE, RAMSEY COUNTY, MINN.

SCALE = 100 FT PER INCH O INDICATES IRON MONT.

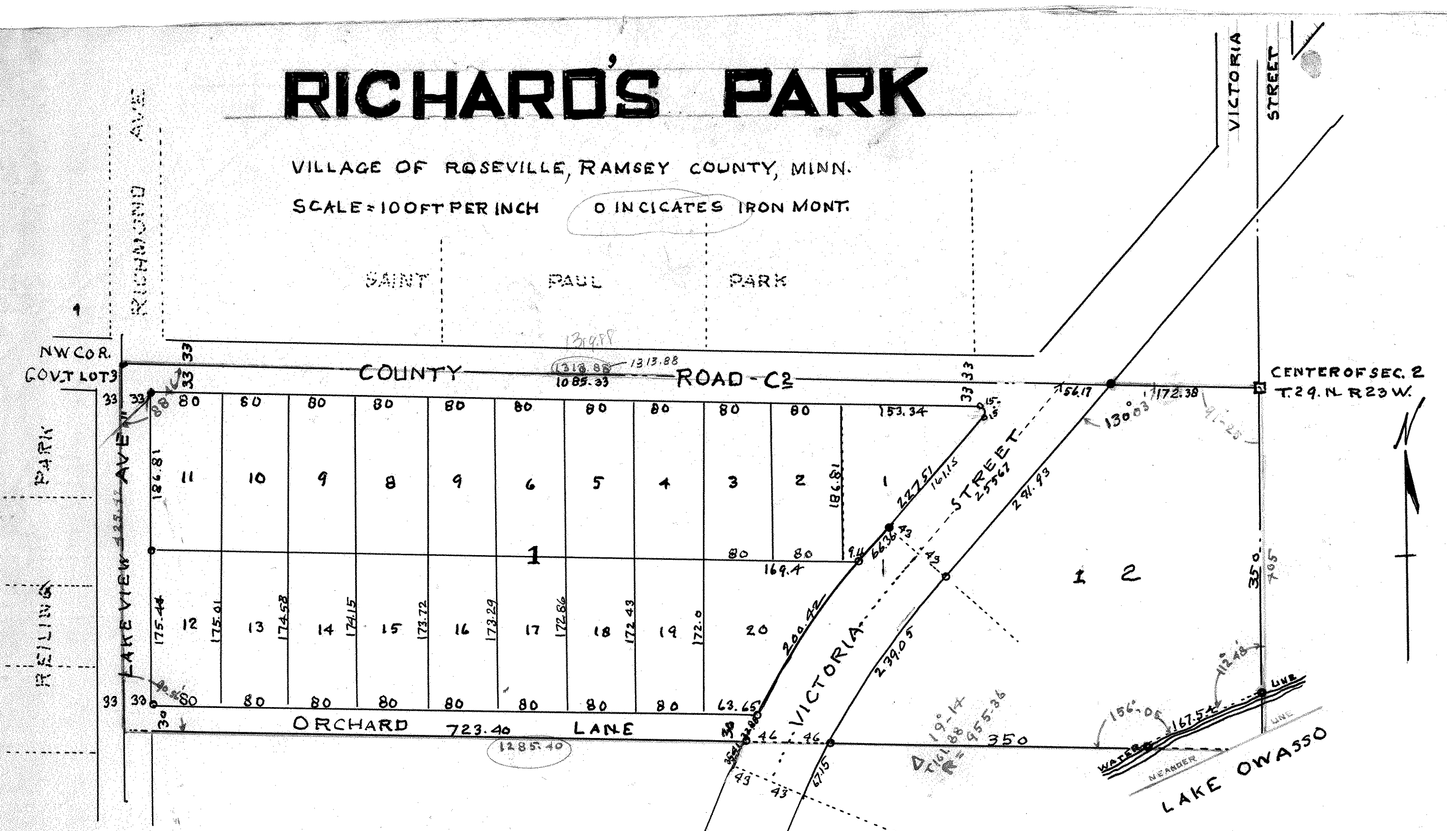

I hereby Certify to having surveyed the property described on this plat as Richard's Park, Village of Roseville, Ramsey County, Minn. and have placed Iron monuments at the Corners as shown and the same is Correct.
There is no low wet ground nor any traveled road or easement on or across same except as shown

Charles Murray

Registered Civil Engineer and Land surveyor.
Minnesota Certificate No 379

State of Minnesota } SS
County of Ramsey }

On this 19th day of July 1949 before me personally appeared Charles Murray to me well known and acknowledged that he executed the foregoing Certificate as his own free act and deed

E. J. Reif

Notary Public, Ramsey County, Minnesota

My Commission expires July 11, 1953

F. J. REIF, Notary Public, Ramsey Co. Minn.
My Commission Expires July 11, 1953

This is to Certify that George J. Reiling and Mary Jane Reiling husband and wife owners of that part of Govt Lot 3 section 2 - T 29 N - R 23 W described as follows: Commencing at the North west Corner of said Govt Lot 3, thence South along the west Line of said Lot 3 a distance of 1254.42 feet, thence East parallel with the South Line of said Lot 3 to the meandered Line of Lake Owasso, thence North easterly along the meandered Line of said Lake to the Center Line of said Sec. 2, thence North along said Center Line to the north Line of said Govt. Lot 3, thence West along the North Line of said Lot 3 to the point of beginning as described in Deeds File 1203941 except the E public road across the same and the use thereof have caused the same to be surveyed and platted and hereafter known as Richards' Park and hereby dedicate to the Public for public use forever all Avenues, streets, roads and Lanes as shown on this plat.

Witness our hands and Seals this 19 day of July 1949

In presence of

Virginia Hayden

Charles Murray

George J. Reiling

Mary Jane Reiling

State of Minnesota } SS
County of Ramsey }

On this 19 day of July 1949 before me the undersigned personally appeared George J. Reiling and Mary Jane Reiling to me known to be the persons described in and who executed the foregoing instrument and acknowledged that they executed the same as their own free act and deed.

Robert J. Reiling

Notary Public Ramsey County, Minnesota.

My Commission expires April 28, 1955

Accepted and approved this 26 day of July 1949

George H. Herrmann
Herbert L. West
Alvah D. Oppenheim } Plat Commissioners

Omelia Rondeau Commissioner of Public Works

accepted and approved by the Council of the Village of Roseville, Ramsey County, Minn. This 14 day of September 1948

Geo. C. Meierding

Village Clerk

Recorded Aug. 2, 1949